

Name William E. & Dolly M. Selfridge

Service No. 2033

Address Cor. North & Adams Streets

Location Same

Kind of Pipe

Size

Size of Main

~~Repair~~ ~~Renewal~~ New Service

Location

Date	Material	Amount	Total	Date	Amount
Aug. 23	32 hrs. @ 50¢	16 00		Aug. 23, 1935 - Deposited	93 00
<i>Comp. 88.49 to Russell 7/10/35</i>	40 " @ 55¢	22 00		Sept. 17, 1935 - Refunded	4 51
	16 " @ 65¢	10 40			88 49
	10% Overhd. on labor	4 84			
	108' 1" Lead Pipe @25¢	27 00			
	6 1" L.L.Coup. @75¢	4 50			
	2 1" L.L.Elbows@90¢	1 80			
	1 1" Nipple (Brass)	20			
	1 1"x3/4" S. & W.	1 75			
			88 49		
	Labor				

Hadley Press, Inc., Lexington

DATE Aug. 22, 1935

TOWN OF LEXINGTON—BOARD OF PUBLIC WORKS

WATER DIVISION

(Beau Property)

The undersigned applies for a supply of water at No. Cor. North & Adams Sts and hereby agrees to comply with the rules and regulations as now, or at any future time, established by the Board of Selectmen.

Paid by Henry S. Milton

Am't. of Estimate \$ 93.00

Owner


Mrs. E. & Dolly M. Selfridge

Am't. Paid \$ 93.00

Address

Builder _____

Sketch of Service Here

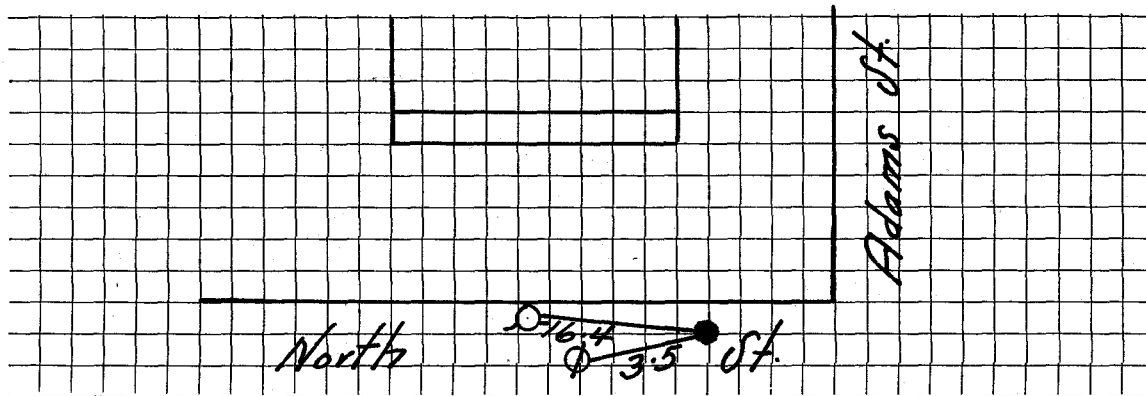

Connection made in _____ Street.

Work completed _____ 19

Remarks: