
Name		Service No.						
Address (1 Cottage Rd							
Location	8					n mann 11 101		
Repair) Renewal - New Service								
Date	Material	Amount	Total	Date		Amount		
4/13/21	I" type kcopper	171		v				
	1			<u> </u>				
	1' curb stop							
	1° curb stop open right camb brass							
<u> </u>	comb. brass							
A STATE OF ATTERNATION OF ATTERNATIO	Buffalo box							
	1							
	1" x3/4" union					<u> </u>		
			···		<u> </u>			
1								
:								
				· · · · · · · · · · · · · · · · · · ·				
		l.		·				
				·				

Date: 4/13/2020

TOWN OF LEXINGTON - BOARD OF PUBLIC WORKS WATER DIVISON

SKETCH OF SERVICE HERE

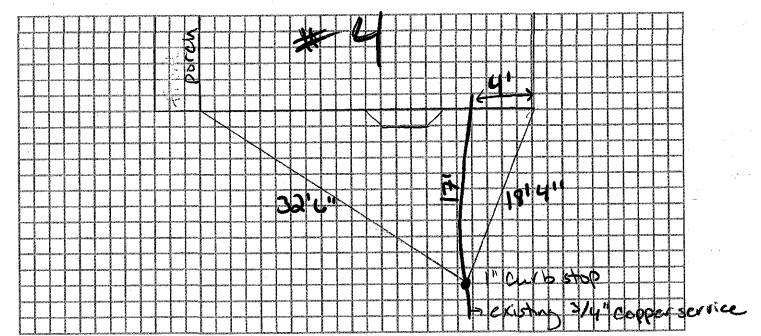

Connection made in:	Street.	Work completed:	IIIMII IOO O O O O O O O O O O O O O O O
Remarks:		oorna oo	нети просили в нап ва на од просистем со од ва се
Replaced 3/4" iron s	WUICE	н приступентивнити приступенти приступенти под приступенти предустви приступенти приступен	ынааакальны ангалыны ангалы ангал

New 1" caper my/ 3/4" to 1" coupling connected to existing cope