

Name Daniel J. O'Connell

2339
Service No. ~~22~~ 665

Address Cottage St., Lexington

Location *11 Cottage St.*

Kind of Pipe

Size

Size of Main

~~Repair - Renewal - New Service~~

Location

Date	Material	Amount	Total	Date	Amount
<i>19-18-28 for 27-45</i>	6' 5/8" L. Pipe @.40	2 40			
	10' 1" C. L. Pipe @.27	2 70			
	2 1" L. L. Ells @.35	70			
	2 1" Br. Sp. Nipl. @.25	50			
	1 S & W	3 00			
	Trucking	75	10 05		
<i>Hadley Press, Inc. Lexington /6/28</i>	25 ¹ Hrs. Labor @.55	13 93			
	2 " " @.60	1 20	15 13		
	15% Overhead		2 27		
			27 45		
	Labor				

*Sept. 22 Cash -
Nov. 6 1925 - Cash*

*16 51
10 64
27 45*

DATE _____

TOWN OF LEXINGTON—BOARD OF PUBLIC WORKS

WATER DIVISION

The undersigned applies for a supply of water at No. _____ St. and hereby agrees to comply with the rules and regulations as now, or at any future time, established by the Board of Selectmen.

Am't. of Estimate \$ _____


Owner _____

Am't. Paid \$ _____

Address _____

Builder _____

Sketch of Service Here

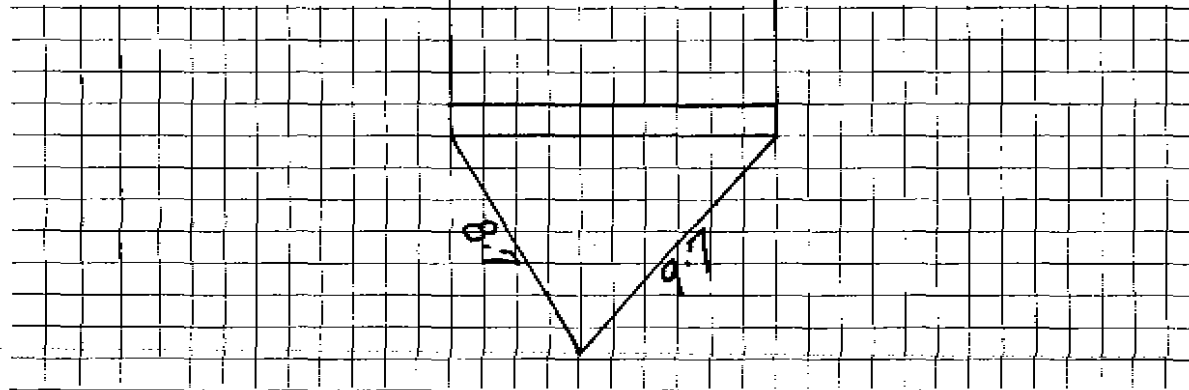

Connection made in _____

Street.

Work completed _____

19

Remarks: