

Name

Service No. 666

Address

2268

Locatic

14 x 16 Cottage St.

Kind of Pipe

Size

6084

Size of Main

Repair—Renewal—New Service

Location

Date

Material

Amount

Total

Date

Amount

Labor

Hadley Press, Inc., Lexington

DATE _____

TOWN OF LEXINGTON—BOARD OF PUBLIC WORKS

WATER DIVISION

The undersigned applies for a supply of water at No. _____ St. and hereby agrees to comply with the rules and regulations as now, or at any future time, established by the Board of Selectmen.

Am't. of Estimate \$ _____

Owner


Am't. Paid \$ _____

Address

Builder _____

S. Lyons
14/16 Cottage St.

Sketch of Service Here

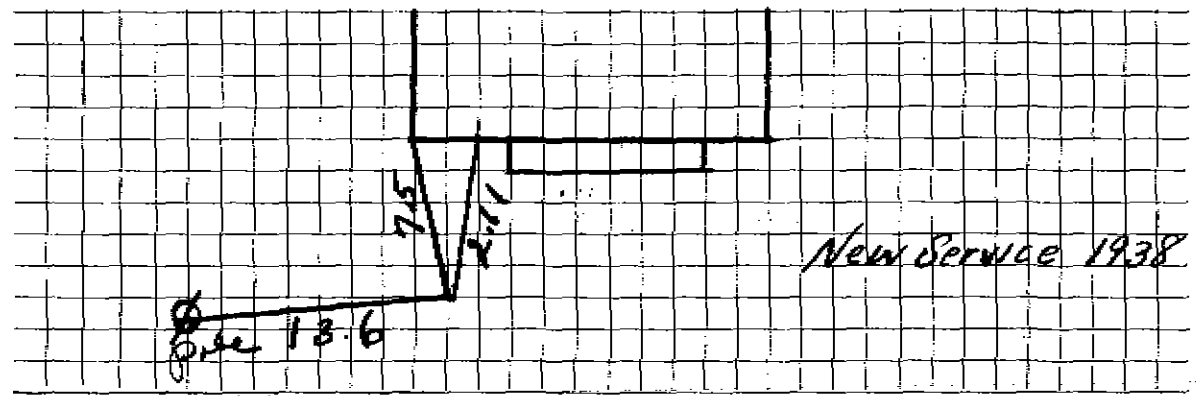

Connection made in _____ Street.

Work completed _____ 19

Remarks: