

Name **Manuel Silva**
 Address **17 Cottage Street, Lexington**

Service No. ~~38~~ **667**
 # ~~625~~
6523

Location

Kind of Pipe

Size

Size of Main

~~Repair~~—Renewal—~~New Service~~

Location

Date 1940	Material	Amount	Total	Date	Amount
July 19	2 hrs. @ 60¢	1 20		July 25, 1940 Deposited	8 00
<i>from 9/9/40</i>	10% Overhead	12	1 32		
	17' 3/4" Copper tubing @ 18¢	3 18	3 06		
	1 3/4" C.x ¹ / ₈ " I.		2 25		
	1 3/4" C.xI Union		65		
	1 3/4" Space nipple		28		
	1 hr. trucking @ 75¢		75		
			<u>8 31</u>		
	Say \$8.00				
	Labor				

Hadley Press, Inc., Lexington

TOWN OF LEXINGTON—BOARD OF PUBLIC WORKS

WATER DIVISION

The undersigned applies for a supply of water at No. _____ St. and hereby agrees to comply with the rules and regulations as now, or at any future time, established by the Board of Selectmen.

Am't. of Estimate \$ _____


Owner _____

Am't. Paid \$ _____

Address _____

Builder _____

Sketch of Service Here

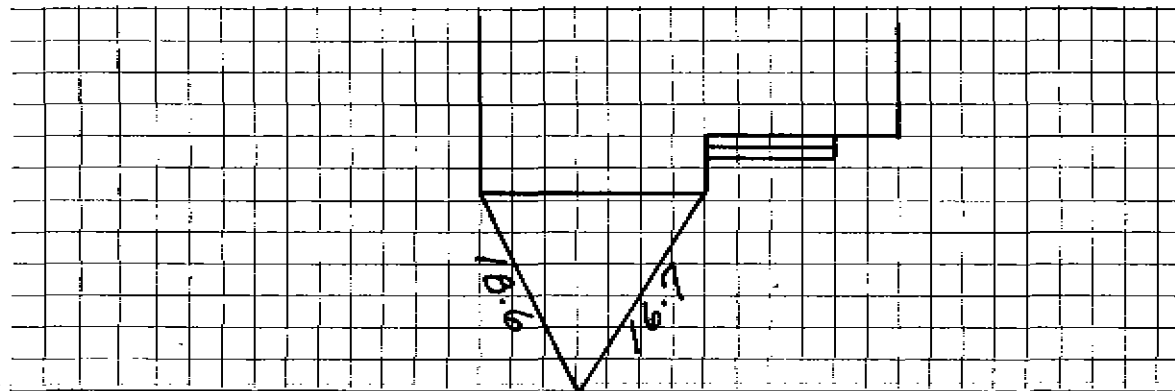

Connection made in _____ Street.

Work completed _____ 19

Remarks: