

Name Carmello Galvagno
 Address 18 Cottage St.

Service No. # 668

Location

Kind of Pipe

Size

Size of Main

~~Repair~~ - ~~Renewal~~ - ~~New Service~~

Location

Huntley Press, Inc., Lexington

Date	Material	Amount	Total	Date	Amount
	6' 1" C.L. Pipe @ .27	1 62			
	1 S & W Trucking	3 00			
		<u>75</u>	5 37		
4/29/29	2 Hrs. Labor @ .60	1 20			
	15% Overhead	<u>18</u>	1 38		
			<u>6 75</u>	July 18/29	6 75
	Labor				

DATE _____

TOWN OF LEXINGTON—BOARD OF PUBLIC WORKS

WATER DIVISION

The undersigned applies for a supply of water at No. _____ St. and hereby agrees to comply with the rules and regulations as now, or at any future time, established by the Board of Selectmen.

Am't. of Estimate \$ _____


Owner _____

Am't. Paid \$ _____

Address _____

Builder _____

Sketch of Service Here

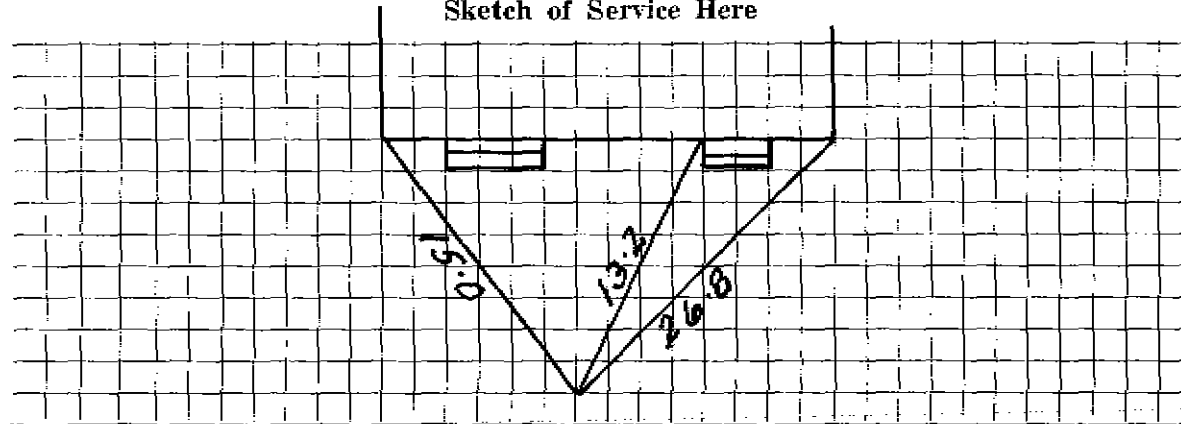

Connection made in _____ Street.

Work completed _____ 19__

Remarks: