


TOWN OF LEXINGTON - BOARD OF PUBLIC WORKS
WATER DIVISION

Date: 7/6/21

SKETCH OF SERVICE HERE

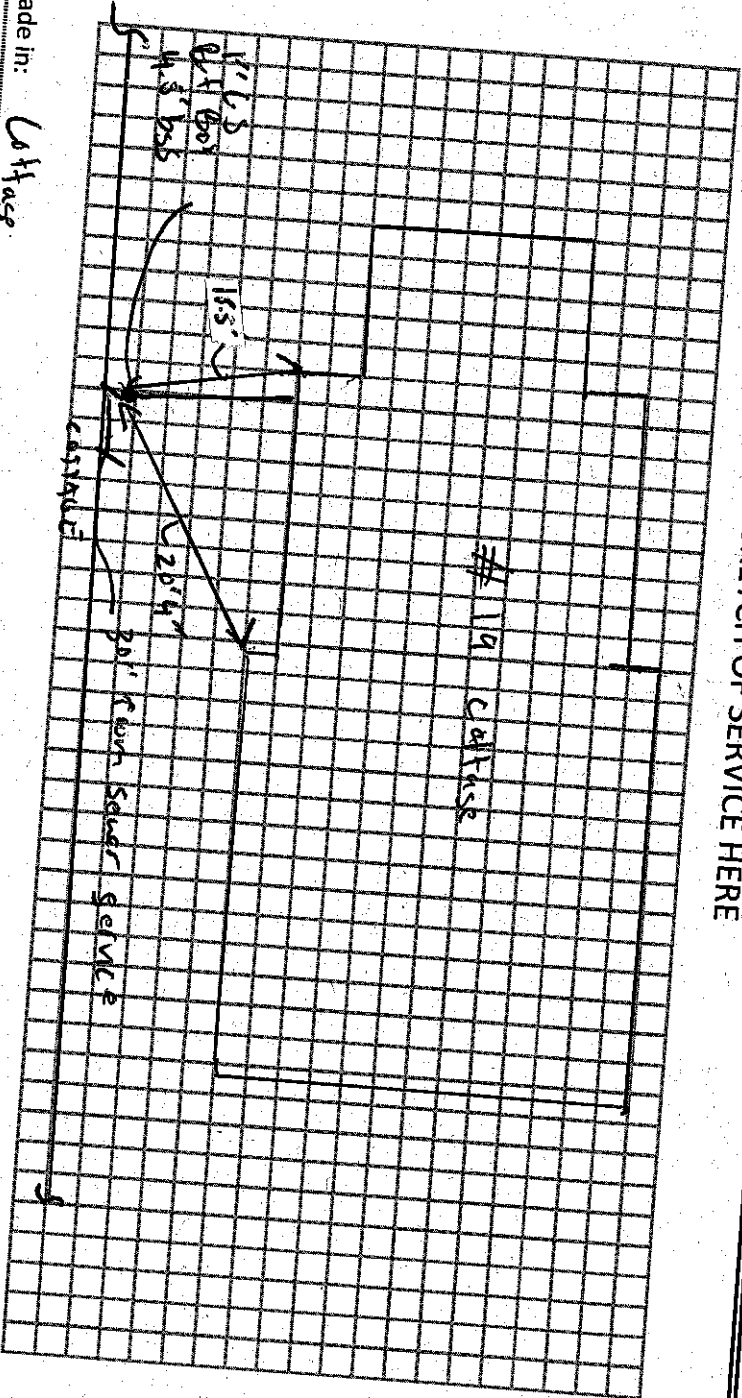

Connection made in: Cat Case

Remarks:

Street:

Work completed:

Perennial WATER

Address 19 Cottage St

Location

Repair - Renewal - New Service

Date	Material	Amount	Total	Date		A
5/18/21	Roto → Husk					
5/18/21	1" C.S. & But Box					
	1" Type K Copper	~ 20'				