

Name *William Sullivan*
Address *22 Cottage Street*

Service No. *669*

Locatio *22 Cottage St.*

Kind of Pipe *COPPER*

Size *3/4"*

Size of Main *8"*

~~Repair—Renewal—New Service~~ *Kirkland #3785*

Location

Date	Material	Amount	Total	Date	Amount
<i>5/5/83</i>	<i>14' 6" x 3/4" Copper Tubing</i>				
	<i>Labor</i>				

Herdley Press, Inc., Lexington

DATE _____

TOWN OF LEXINGTON—BOARD OF PUBLIC WORKS

WATER DIVISION

The undersigned applies for a supply of water at No. _____ St. and hereby agrees to comply with the rules and regulations as now, or at any future time, established by the Board of Selectmen.

Am't. of Estimate \$ _____

Owner

Mrs A Sullivan


Am't. Paid \$ _____

Address

22 Cottage St.

Builder _____

Sketch of Service Here

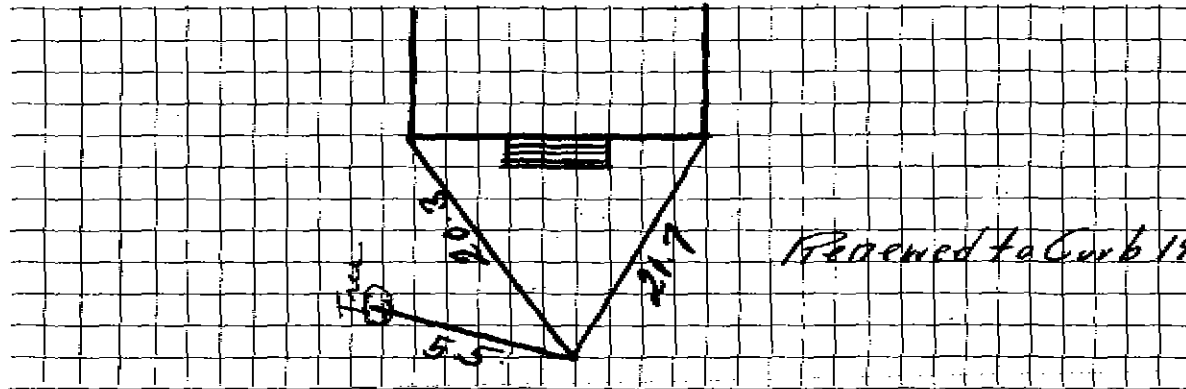

Renewed to Curb 1938

Connection made in _____ Street.

Work completed _____ 19

Remarks: