

WATER SERVICE RECORD

1388

Service No. 49

Name Joseph Carney

Address 23 Cottage Street

1389

Location

Repair—Renewal—New Service W.O. #7273


NOV 18 1968

Date	Material	Amount	Total	Date	Amount
8/29/68	Labor	46 40		8-24-68	85 00
	10% O.H.	4 64	51 04	11-18-68	8 86
11'	3/4" copperpipe @ .79		8 69		76 14
1	3/4" wheel valve		9 30	1938	RENEWED TO CURB
1	3/4" copper to iron fitting		1 81		
1/2	Yd. loam @ 3.50		1 75		
1/2	Lb. grass seed @ 1.10		55		
1	Hr. trucking		3 00		
			76 14		

DATE _____

TOWN OF LEXINGTON — BOARD OF PUBLIC WORKS
WATER DIVISION

Sketch of Service Here

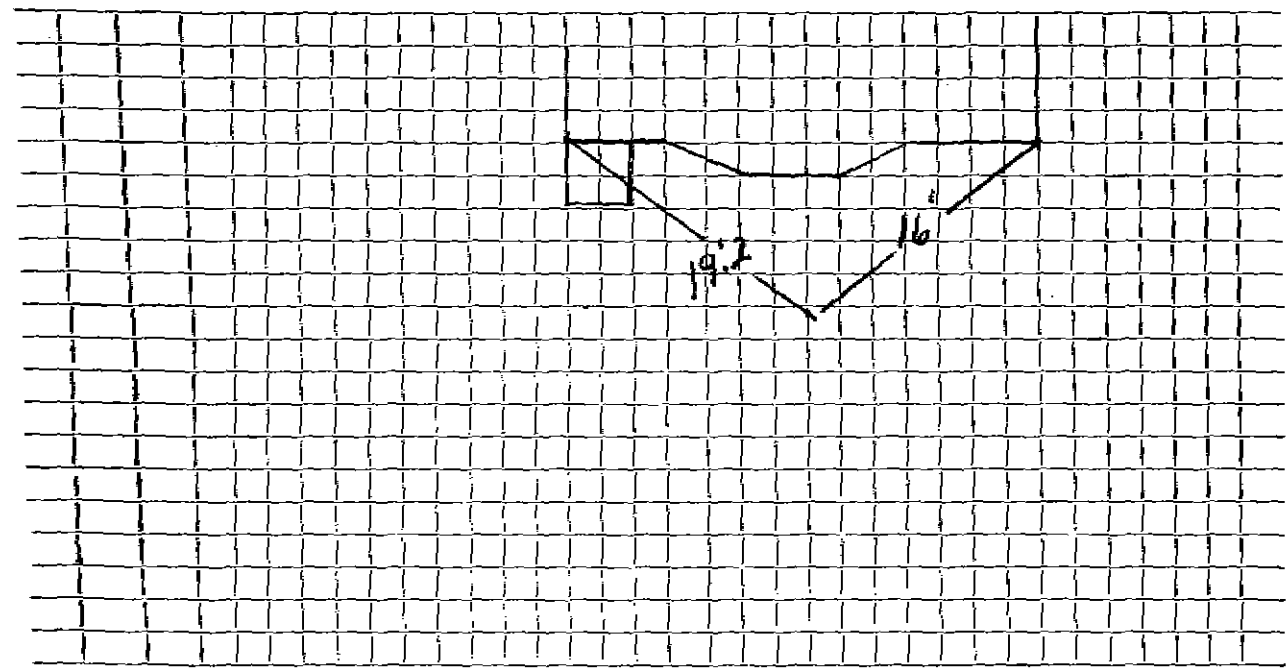

Connection made in Street. Work completed

Remarks:
.....
.....