




DATE \_\_\_\_\_

**TOWN OF LEXINGTON BOARD OF PUBLIC WORKS**  
**WATER DIVISION**

Sketch of Service Here

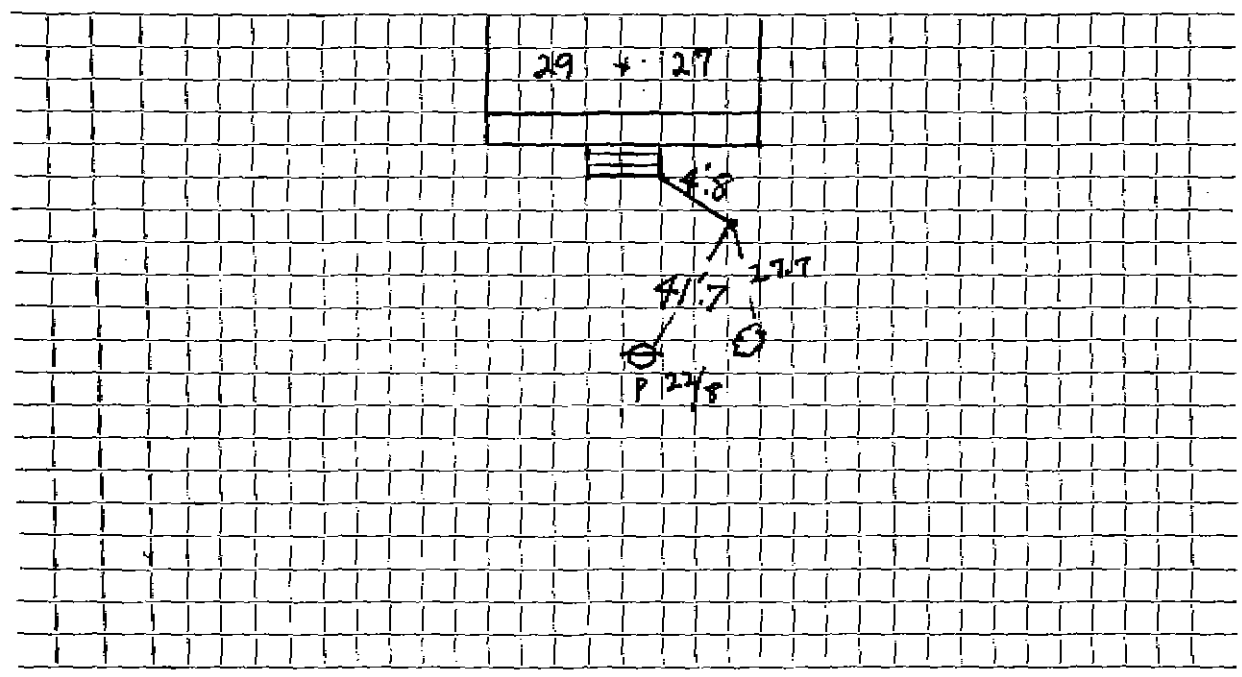

Connection made in \_\_\_\_\_ Street. Work completed \_\_\_\_\_

Remarks: *This MAY SHUT off 31+33 ALSO*

.....  
.....