

6676

WATER SERVICE RECORD

Name **BRUCE** Jordan

Service No. 126

Address 30 Cottage Street

Location

~~Repair~~ Renewal ~~New Service~~

Comm 11-13-61


Date	Material	Amount	Total	Date		Amount
9/1/61	Labor	4 05		9-1-61	Deposit	30 00
	10% O.H.	<u>41</u>		11-13-61	Refund	<u>3 77</u>
			4 46			26 23
	30' 3/4" Copper Tubing @ .42		12 60			
	1 3/4" Cx 1/2 IWH Stop & Waste		6 17			
	1 Hr. Trucking @ 3.00		<u>3 00</u>		NON-SERVICE	
			26 23		1 1/2 Straight Tailpiece	50
					1 1/2 Offset Tailpiece	<u>50</u>
						1 00

DATE _____

TOWN OF LEXINGTON — BOARD OF PUBLIC WORKS

WATER DIVISION

Sketch of Service Here

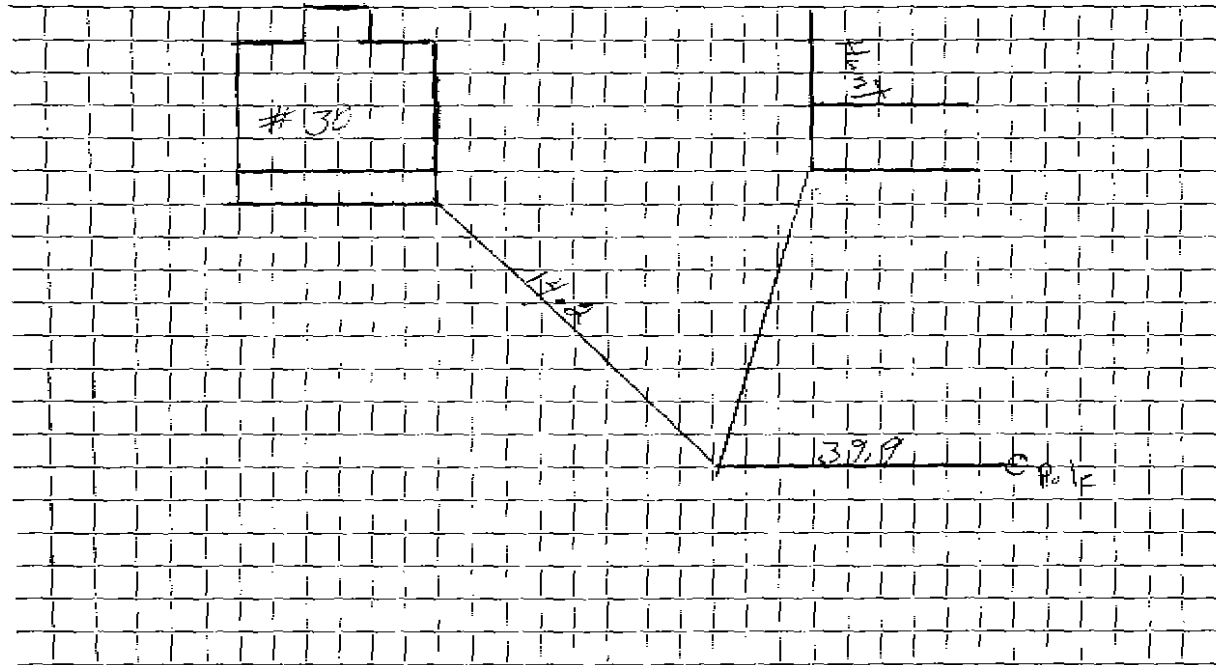

Connection made in Street. Work completed

Remarks:

.....
.....