

WATER SERVICE RECORD

Name Scanlan & Kavanagh Inc.

Service No. 146

Address 31 - 33 Cottage Street

Location Valeri Const. - Permit #170

Repair - Renewal - New Service ~~XXXXXXXXXX~~ W.O. #9390

FEB 15 1965
FEB 15 1965


Date	Material	Amount	Total	Date	Amount
12-15-64	23' 3/4" Copper tubing			11-30-44	Deposit 100.00
	CURB TO MAIN				
12-14-64	Labor	38.45			
12-15-64	Labor	61.51	99 96		
	10% O. H.	10 00	109 96		
66'	3/4" Copper tubing @ .42		27 72		
1	3/4" 3 Part Union		3 01		
1	3/4" 2 Part Union		1 80		
1	1 1/2 x 1 1/2" Brass Tee		2 35		
1	1 1/2 x 3/4" Bushing		1 20		
1	1 1/2 Style 38 Clamp		2 50		
1	1 1/2 x 6 Cement Lined Nipple		75		
1	3/4" Curb Cock		8 76		
1	3/4" Brass Nipple		70		Bill sent 9-2-54
1	Box & Rod		4 90	3	Hrs Town Truck @3.00 9 00
5 1/2	Ton Peastone @ 1.75		9 19	1	Hr. Loader 4 00
2	Hrs Town Shovel @ 6.50		13 00		198 84

DATE _____

TOWN OF LEXINGTON — BOARD OF PUBLIC WORKS

WATER DIVISION

Sketch of Service Here

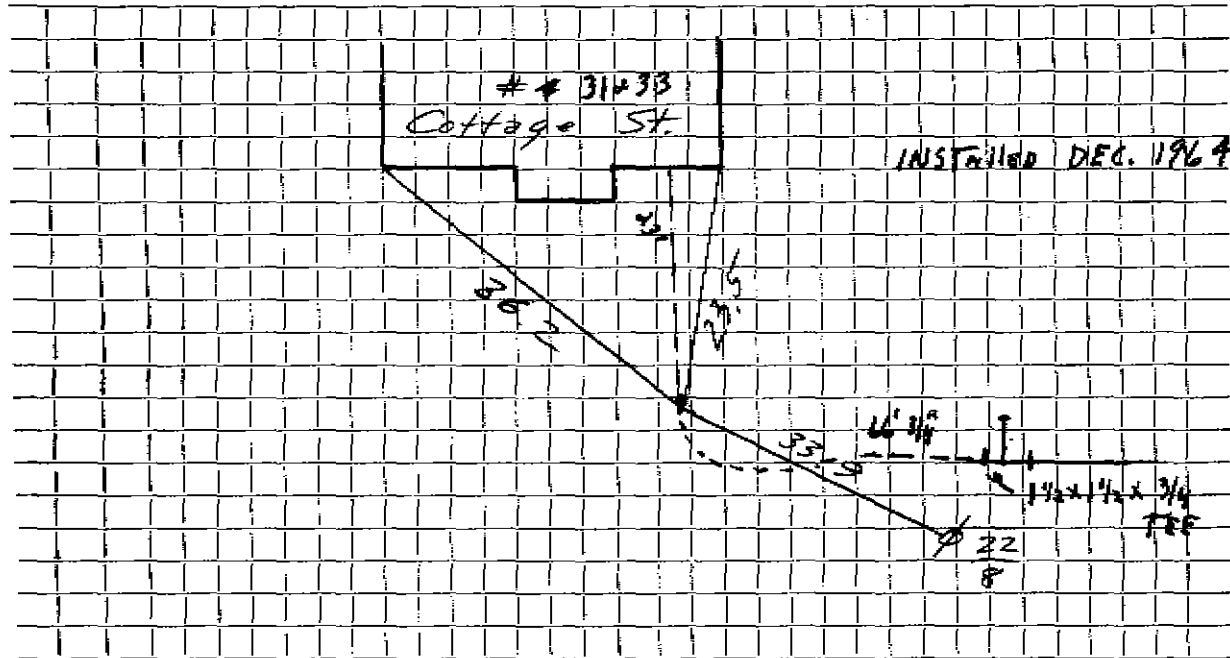

Connection made in Street. Work completed

Remarks: ~~Existing water service to Cottage Street to be abandoned for this property, but to be used for #45 Weburn Street.~~ This house to go out to Cottage Street to 1 1/2" service on street.