

Name

Service No. 675

Address

2794

2918

Locatic

40 Cottage St.

Kind of Pipe

Size

Size of Main

Repair—Renewal—New Service

Location

Date	Material	Amount	Total	Date	Location	Amount
	Labor					

Hadley Engine, Inc., Lexington

DATE _____

TOWN OF LEXINGTON—BOARD OF PUBLIC WORKS

WATER DIVISION

The undersigned applies for a supply of water at No. _____ St. and hereby agrees to comply with the rules and regulations as now, or at any future time, established by the Board of Selectmen.

Am't. of Estimate \$ _____


Owner S. Donnellan.

Am't. Paid \$ _____

Address 40 Cottage.

Builder _____

Sketch of Service Here

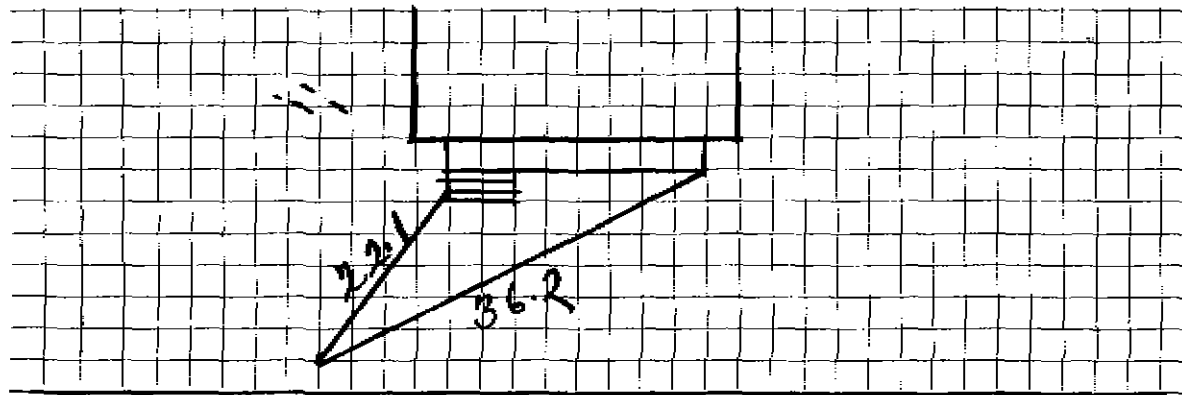

Connection made in Cottage Street. St Work completed _____ 19__

Remarks: