

Name Mrs. Catherine & Miss Katherine Vaughan

1212 Service No. 661-19

Address 5 Cottage St.

Location

Kind of Pipe

Size

Size of Main

~~Repair—Renewal—New Service~~

Location

Date	Material	Amount	Total	Date	Amount
Com. 16 00	16' $\frac{3}{4}$ " Copper Pipe				
9-15-31	1 $\frac{3}{4}$ " x 1" C. to I. Union			Aug. 21 1931 - Cash	16 50
	1 1" C. to I. Union				
	1 1" Br. Sp. Nip.				
	1 S & W				
8/21/31	7 Hrs. Labor @ .55				
	2 " " @ .60				
	15% Overhead				
	<u>CHARGE</u> 16 ft. @ .75	\$12 00	\$12 00		
	Labor				

Hadley & Co., Inc., Lexington

DATE 8/21/31

# TOWN OF LEXINGTON—BOARD OF PUBLIC WORKS

## WATER DIVISION

The undersigned applies for a supply of water at No. 5 Cottage St. and hereby agrees to comply with the rules and regulations as now, or at any future time, established by the Board of Selectmen.

Am't. of Estimate \$ 16.00


Owner Mrs. Catherine & Katherine Vaughn

Am't. Paid \$ 16.00

Address 5 Cottage St.  
Lexington Mass.

Builder \_\_\_\_\_

Sketch of Service Here

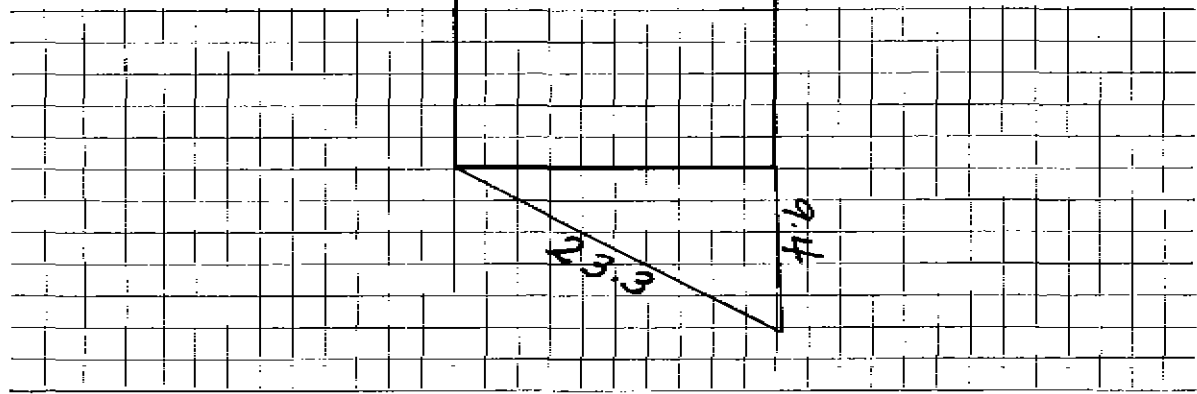

Connection made in \_\_\_\_\_ Street. Work completed \_\_\_\_\_ 19

Remarks: