

WATER SERVICE RECORD

Name Alden Jeffs

Service No. 175

Address 8 Cottage Street

Location

~~Repair~~ - Renewal ~~New Service~~

Comm 12-18-61


Date	Material	Amount	Total	Date	Amount
11/9/61	Labor	73 46		11-1-61	100 00
	10% O.H.	7 35	80 81	8-29-62	43 18
60'	3/4" Copper Tubing @ .42		25 20	1938 RENEWED To Curb 143 18	
1	3/4" Cx 1/2 IWH Stop & Waste		6 17		
2	Hrs. Trucking @ 3.00		6 00		
5	Hrs. Pippin Shovel @ 5.00		25 00	11/9/61	1 1/2 Straight Tailpiece 50
			143 18		1 1/2 Offset Tailpiece 50
					1 00

DATE _____

TOWN OF LEXINGTON — BOARD OF PUBLIC WORKS

WATER DIVISION

Sketch of Service Here

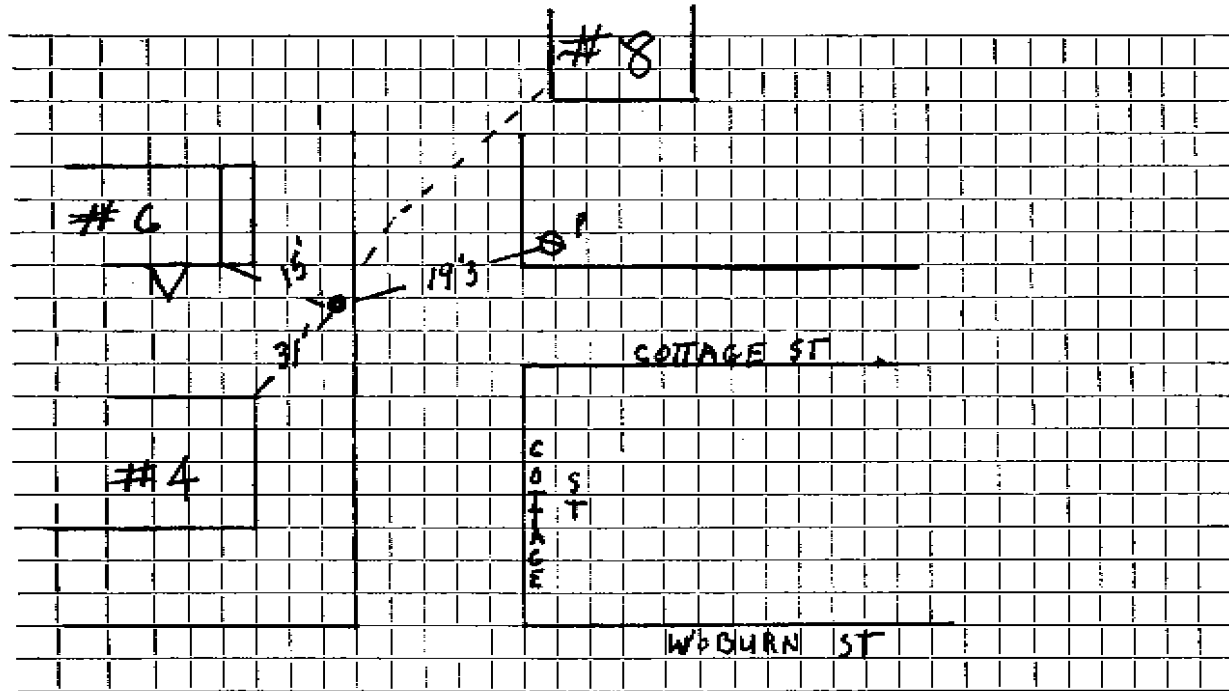

Connection made in Street. Work completed

Remarks: *1938 Renewed To Curb*

.....
.....