




Date: 6/16/22

TOWN OF LEXINGTON - BOARD OF PUBLIC WORKS  
WATER DIVISION

SKETCH OF SERVICE HERE

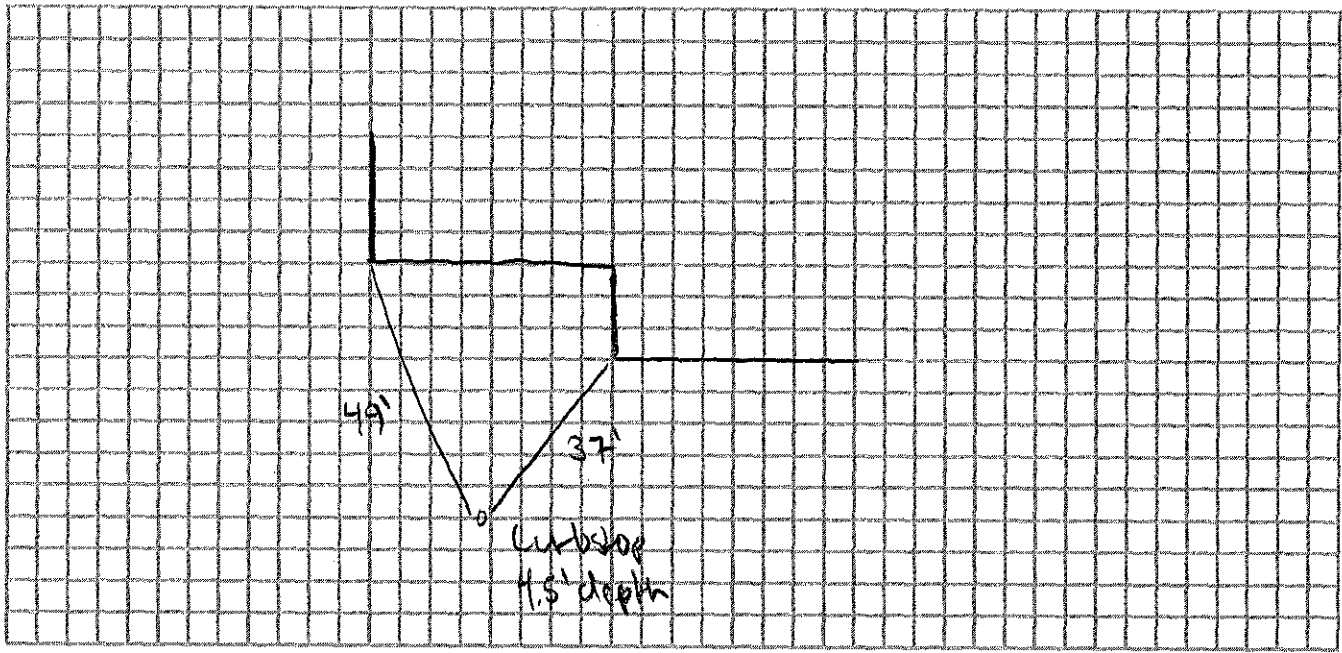

Connection made in: CRAWFORD RD Street. Work completed:

Remarks: INSTALLED BY BOULEY EXCAVATION