

Name Benjamin J. Selfridge

Service No.

~~101~~ 679

Address

~~52 Moulton Road, Arlington~~
11 Crescent Hill ~~2nd~~ Ave. #11 Crescent Hill Ave
Location 2nd on right from Reed St.

#6014

#6397

Kind of Pipe

Size

Size of Main

~~Repair - Renewal - New Service~~

NEW SERVICE

Location

Date

Material

Amount

Total

Date

Amount

11-27-28
for
35-00

36' 1" C.L. Pipe @.27

9 72

1 1" L.L. Ell

35

2 1" L.L. Coup. @.30

60

1 1" Br. Sp. Nipple

25

1 S & W

3 00

Trucking

75

14 67

Checked
11-15-93

Nov. 7 1925 Cash

35

Outside

3/4 Copper

11/14/28

30 Hrs. Labor @.55

16 50

2 " " @.60

1 20

17 70

15% Overhead

2 66

35 03

Labor

Layrite

Hadley Press, Inc. Lexington

DATE Nov. 7, 1928

TOWN OF LEXINGTON—BOARD OF PUBLIC WORKS

WATER DIVISION

The undersigned applies for a supply of water at No. ^{Lot} 52 B. Crescent Village St. and hereby agrees to comply with the rules and regulations as now, or at any future time, established by the Board of Selectmen.

Am't. of Estimate \$ _____

Owner Benjamin F. Selfridge


Am't. Paid \$ _____

Address 52 Moulton Rd

Builder Benjamin F. Selfridge

Carl

Sketch of Service Here

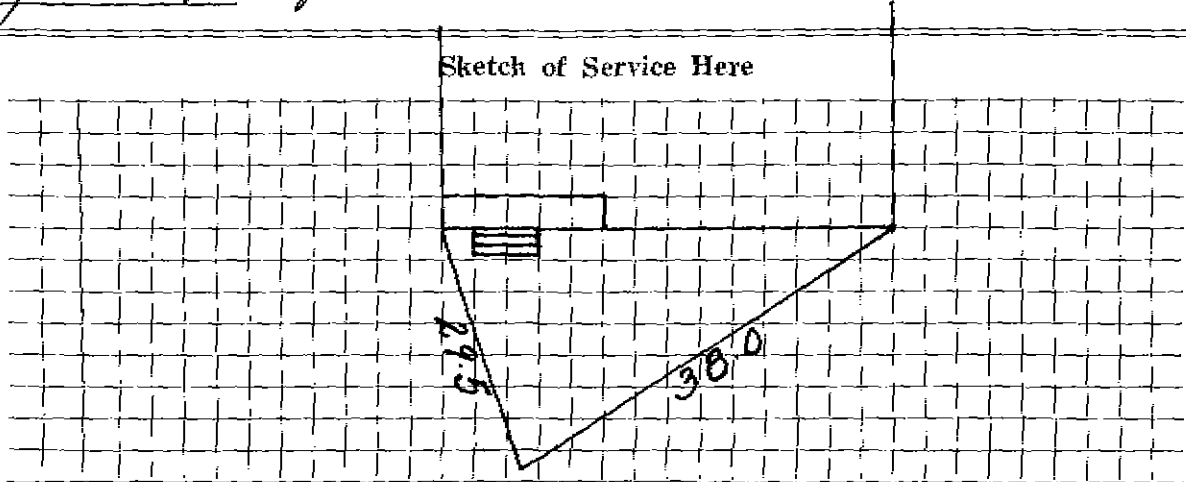

Connection made in _____ Street. Work completed _____ 19

Remarks: