

#6504

WATER SERVICE RECORD

Name

Service No.

Address 12 Crescent Hill Avenue

Location


Repair—~~REPAIR TO MAIN SERVICE~~ W.O. #5403

Date	Material	Amount	Total	Date	Amount
9/19/67	Labor	53 70			
	10% O.H.	5 37	59 07		
20'	3/4" copper tubing @.79		15 80		
1	3/4" corp. Adapter				
1	3/4" curb stop				
1	1" x 3/4" reducing coupling				
1	3/4" x 3" nipple				
1	3/4" repair clamp				
1	Box & Rod				
3	Hrs. Shovel @ 6.50				
1	Hr. Trucking				
9/20/67	Patching		29 61		
1/2	Hr. Shovel @ 6.50				
2	Hr. Trucking @ 3.00				
1/2	Hr. Roller @ 3.00				
1/2	Hr. Compressor @ 5.00				

DATE \_\_\_\_\_

**TOWN OF LEXINGTON — BOARD OF PUBLIC WORKS**  
**WATER DIVISION**

Sketch of Service Here

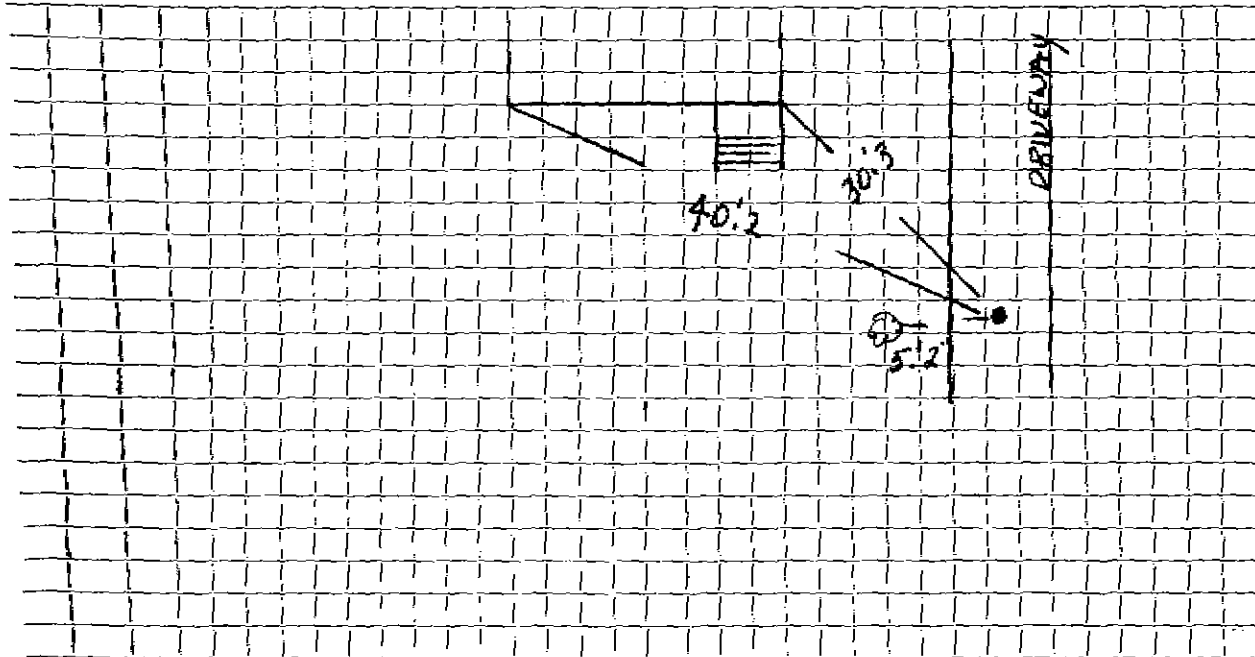

Connection made in ..... Street. Work completed .....

Remarks: .....

.....  
.....