


DATE 11-16-93

TOWN OF LEXINGTON — BOARD OF PUBLIC WORKS

WATER DIVISION

Sketch of Service Here

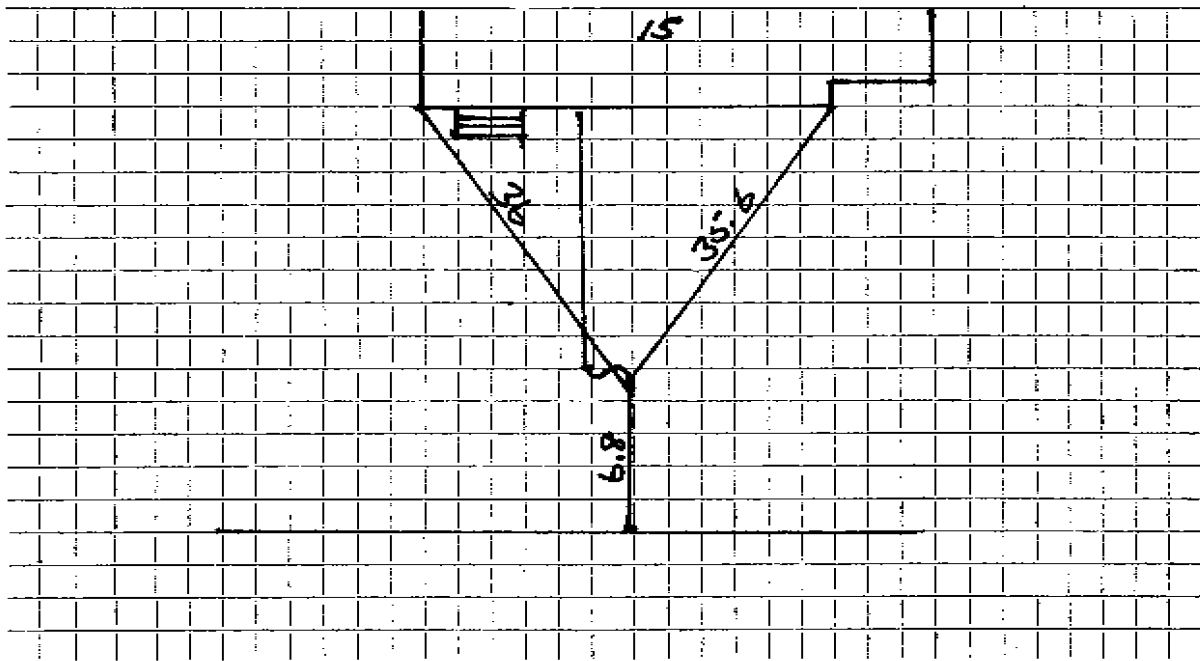

Connection made in Street. Work completed 11-16-93

Remarks: Iron pipe is under tree roots