

WATER SERVICE RECORD

Name Albert E. Lloyd

Service No. 276

Address 16 Crescent Hill Avenue

Location _____

~~Repair~~ ~~Renewal~~ ~~New Service~~

Conn 12-31-59


Date	Material	Amount	Total	Date	Amount
10-22-59	Labor	3.70		10-22-59	35.00
	10% O.H.	.37	4.07	12-31-59	15.00
22'	3/4" Copper tubing @.42	9.24			19.94
1	3/4" C x 1/2 I.W.H. Stop & Waste	5.88			NON CHARGE
1	hr. Trucking @.75	.75			Labor
			19.94		25.94
				4'	3/4" Copper tubing @.42
				1	3/4" C Adapter
				1	3/4" C Curb Cock
				1	3/4" C Corp Cock
				1	Box & Rod
				1	1/2 Straight tailpiece
				1	1/2 Offset tailpiece
				2	hrs. Pippin Shovel @4.50
					9.00
					55.12

DATE _____

TOWN OF LEXINGTON — BOARD OF PUBLIC WORKS

WATER DIVISION

Sketch of Service Here

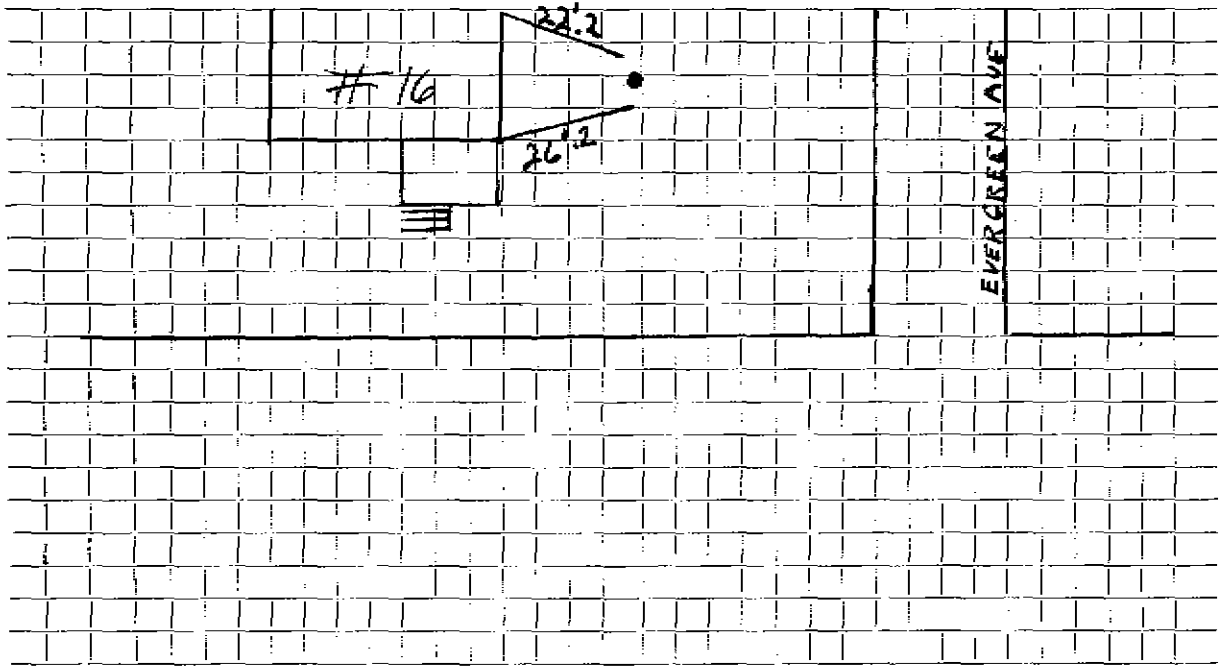

Connection made in Crescent Hill Ave. (old CARD) street.

Work completed

Remarks:

.....

.....