

WATER SERVICE RECORD

Name

Service No.

Address 21 Crescent Hill Ave

Location

Repair—Renewal—New Service


Date	Material	Amount	Total	Date	Amount
	Inside				Outside :
	1" C.L. Pipe			11-17-93	8.6 3/4 Copper
					1 3/4 x 1 Cop. Iron Adp.
					1 3/4 Comp. Corp. Adp.
					1 3/4 Comp. Curb
					1 Box + Rod

DATE 11-17-93

TOWN OF LEXINGTON — BOARD OF PUBLIC WORKS

WATER DIVISION

Sketch of Service Here

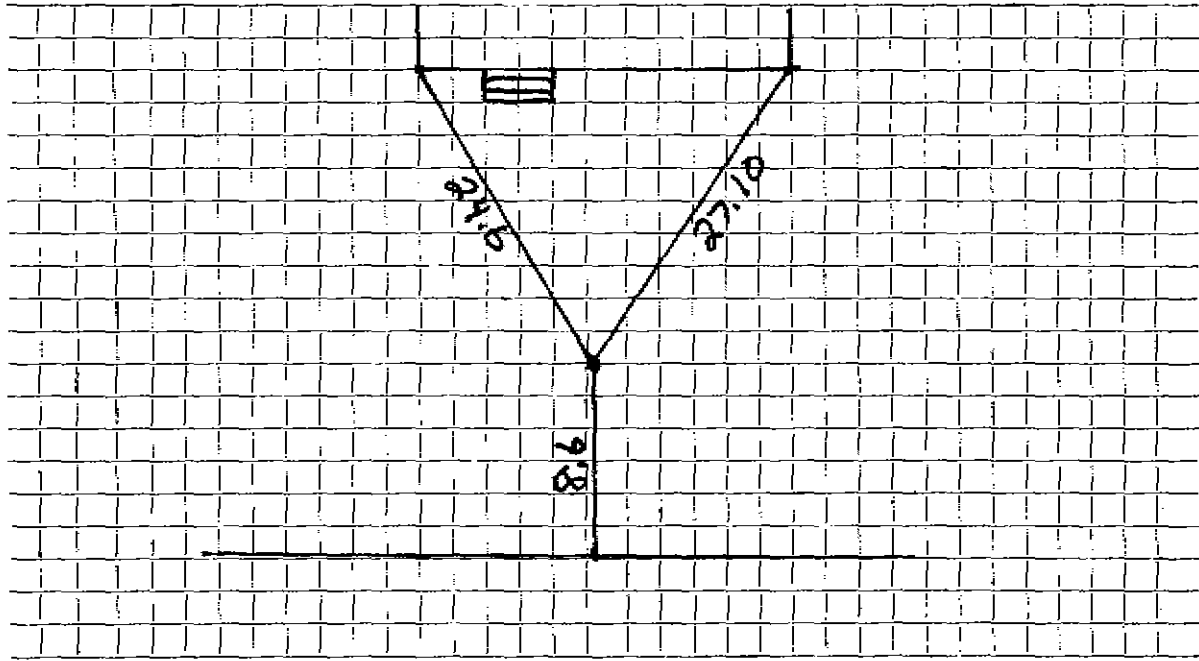

Connection made in ..... Street. Work completed 11-17-93.....

Remarks: 3/4 Copper 1' under old gas service.....