

WATER SERVICE RECORD

Name

Service No.

Address 22 Crescent Hill Avenue

Location

Repair—Renewal—New Service


| Date | Material | Amount | Total | Date | Amount |
|---------|------------------------|--------|-------|-----------------------------|--------------|
| 8/10/28 | 25' 1" C.L.P. 1 S+W | | | | |
| | | | | NON CHARGE | |
| | | | | 3/28/58 Labor | 61 44 |
| | | | | 25' 3/4" Copper tubing @ 37 | 9 25 |
| | | | | 1 3/4" C Corp Cock | 4 64 |
| | | | | 3 Hours Town Shovel @ 6.50 | 19 50 |
| | | | | 2 Hours Trucking @ 75 | 1 50 |
| | | | | | <u>96 33</u> |

DATE _____

TOWN OF LEXINGTON — BOARD OF PUBLIC WORKS

WATER DIVISION

Sketch of Service Here

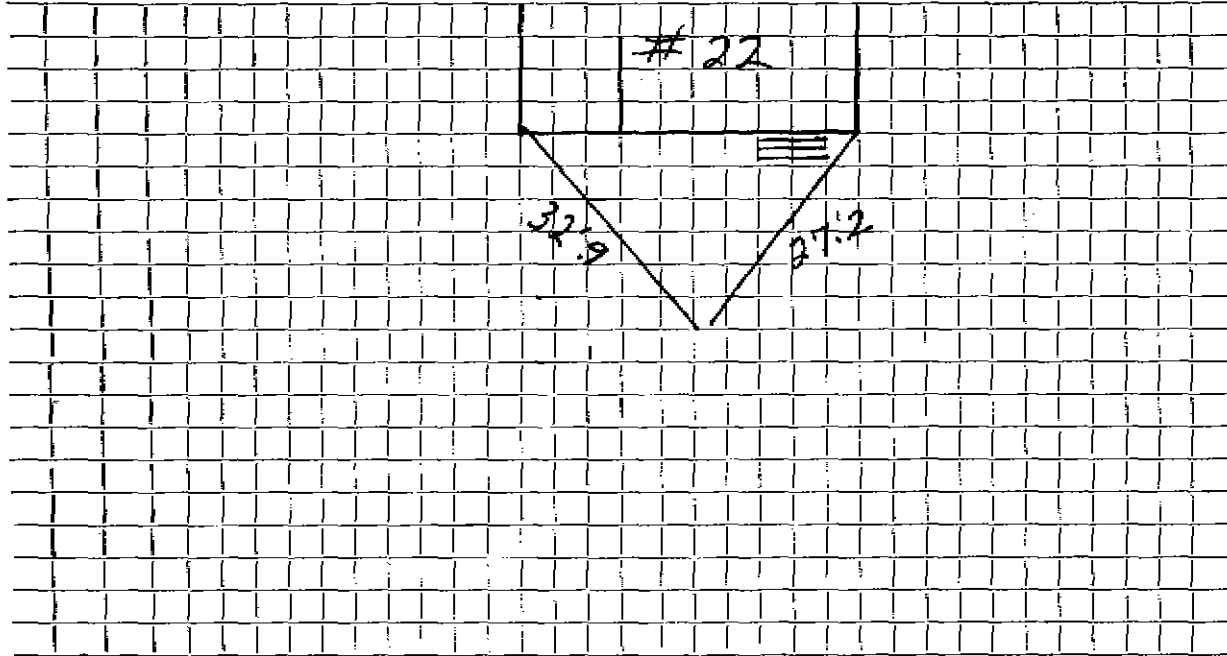

Connection made in Street. Work completed

Remarks: COR. OF EVERGREEN AVE

.....
.....