

WATER SERVICE RECORD

Name John Hynes
 Address 23 Crescent Hill Ave.
 Location _____

Service No. 8
 Repair—Renewal—New Service NO # 598


MAY 29 1973

Date	Material	Amount	Total	Date	Amount	
3-19-73	Labor	68.52		3-16-73	Deposit	350 00
	10% O. H.	6.85	75.37	5-29-73	Refund	216 62
35'	3/4 copper tubing @ .79		27 65			133 38
1	3/4 wheel valve		12 01			
1	1/2 brass coupling		60			
1/2	yd. loam @ 3.50		1 75			
1	hr. trucking		3 00			
2	hrs. shovel @ 6.50		13 00			
			133 38			

DATE _____

TOWN OF LEXINGTON — BOARD OF PUBLIC WORKS
WATER DIVISION

Sketch of Service Here

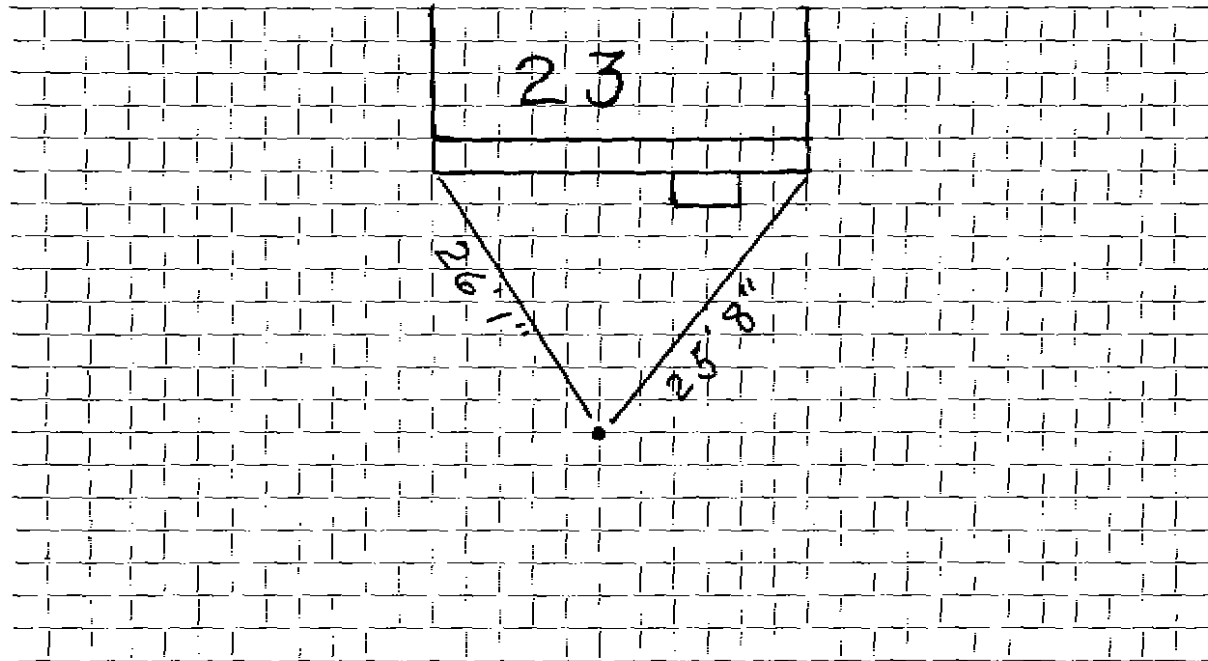

Connection made in Street. Work completed

Remarks: *Original 4-11-29*