

Name

Service No. 689

Address 25 Crescent Hill Ave.

Location 25 Crescent Hill Ave.

Kind of Pipe

Size

Size of Main

Repair—Renewal—New Service

Location

Date	Material	Amount	Total	Date	Amount
	Labor				

Hadley Press, Inc., Lexington

DATE _____

TOWN OF LEXINGTON—BOARD OF PUBLIC WORKS

WATER DIVISION

The undersigned applies for a supply of water at No. _____ St. and hereby agrees to comply with the rules and regulations as now, or at any future time, established by the Board of Selectmen.

Am't. of Estimate \$ _____

Owner

A England


Am't. Paid \$ _____

Address

~~128~~ Crescent Hill ave
25

Builder _____

Sketch of Service Here

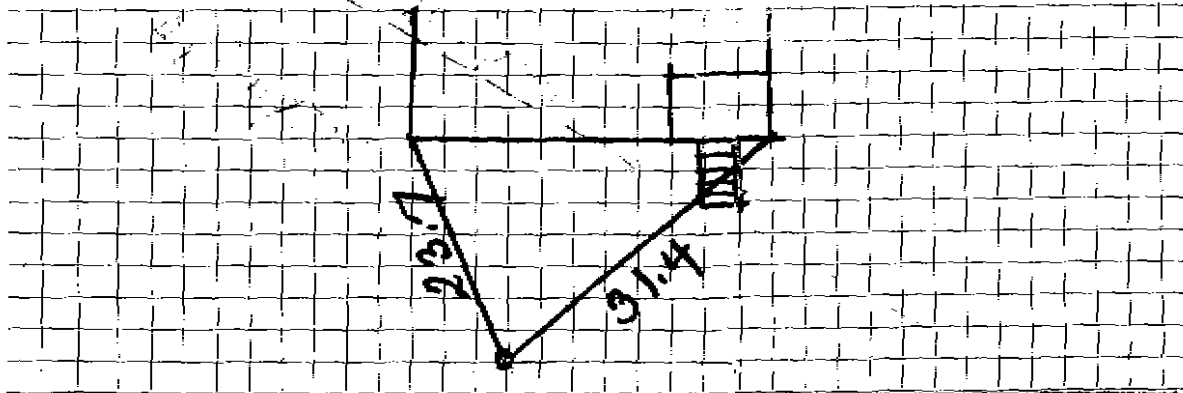

Connection made in Crescent Hill Street. ave Work completed _____ 19

Remarks: