

WATER SERVICE RECORD

#1342

Name Michael Graziano

Service No. 129

Address 7 Crescent Hill Avenue

Location Lexington, Mass.

~~Repair - Repair~~ - New Service


12-9-51

Date	Material	Amount	Total	Date	Amount
6/14/51	Labor	4 03	4 03	6-13-51	Deposited 50 00
	10% overhead		40	9-24-51	Refunded 12 48
	44' -3/4" copper tubing @.326	14 34			No Charge 46 52
	1 -3/4" CX $\frac{1}{2}$ I.W.H. stop&waste	4 00		6/14/51	Labor 8 17
	2 hrs. Littlefield shovel	7 00	14 00		12' -3/4" copper tubing @.326 3 91
	1 hr. trucking		75		1 - 3/4" C. corp-cock 4 33
	Patching 9 x 3		9 00		1 -3/4" CX3/4" C. curb-cock 4 67
			46 52		1 - box and rod 4 68
					1 - 1/2 offset tail piece 50
					1 - 1/2 straight tail piece 50
					1 hr. Littlefield shovel 7 00
					1 hr. trucking 75
					34 51

DATE _____

TOWN OF LEXINGTON — BOARD OF PUBLIC WORKS
WATER DIVISION

Sketch of Service Here

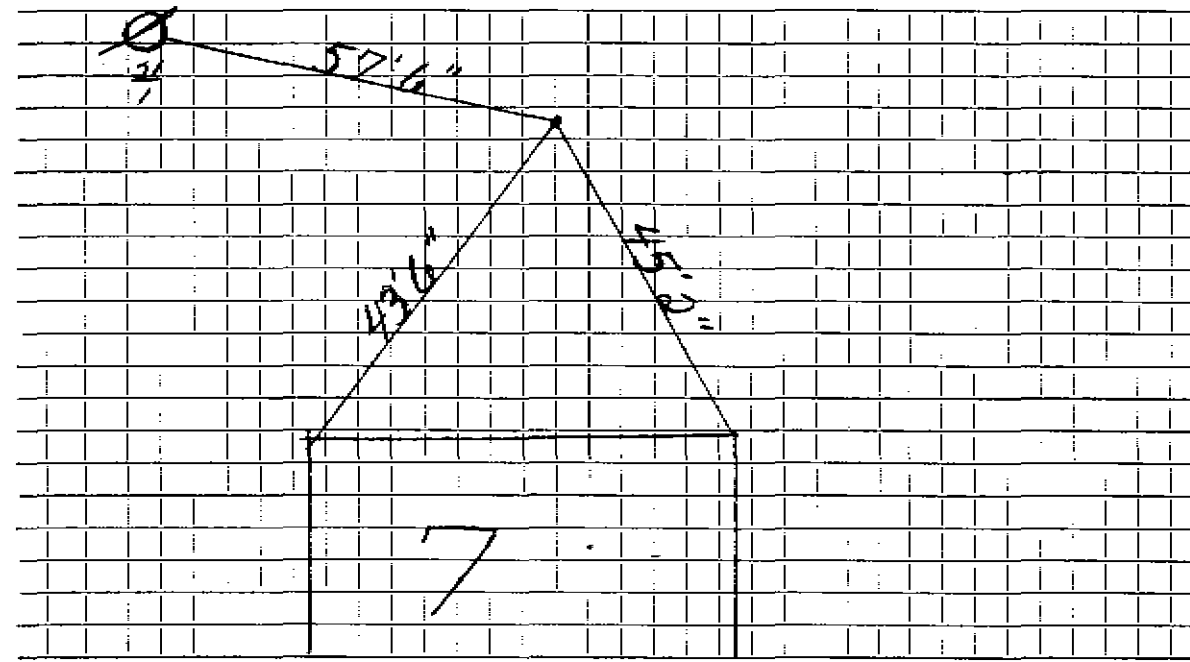

Connection made in Street. Work completed

Remarks:
.....
.....