

WATER SERVICE RECORD

Name

Service No.

Address 8 Crescent Hill Ave

Location

Repair—Renewal—New Service


Date	Material	Amount	Total	Date	Material	Amount
	Inside				Outside:	
	1'-C.L. Pipe			11-9-93	24.2 - 3/4 Copper	
					1- 3/4 x 1 Cop-Iron Adp.	
					1- 3/4 Comp Curb.	
					1- 3/4 Comp Comp Adp.	
					1- Box + Rod	

DATE 11-10-93

TOWN OF LEXINGTON — BOARD OF PUBLIC WORKS

WATER DIVISION

Sketch of Service Here

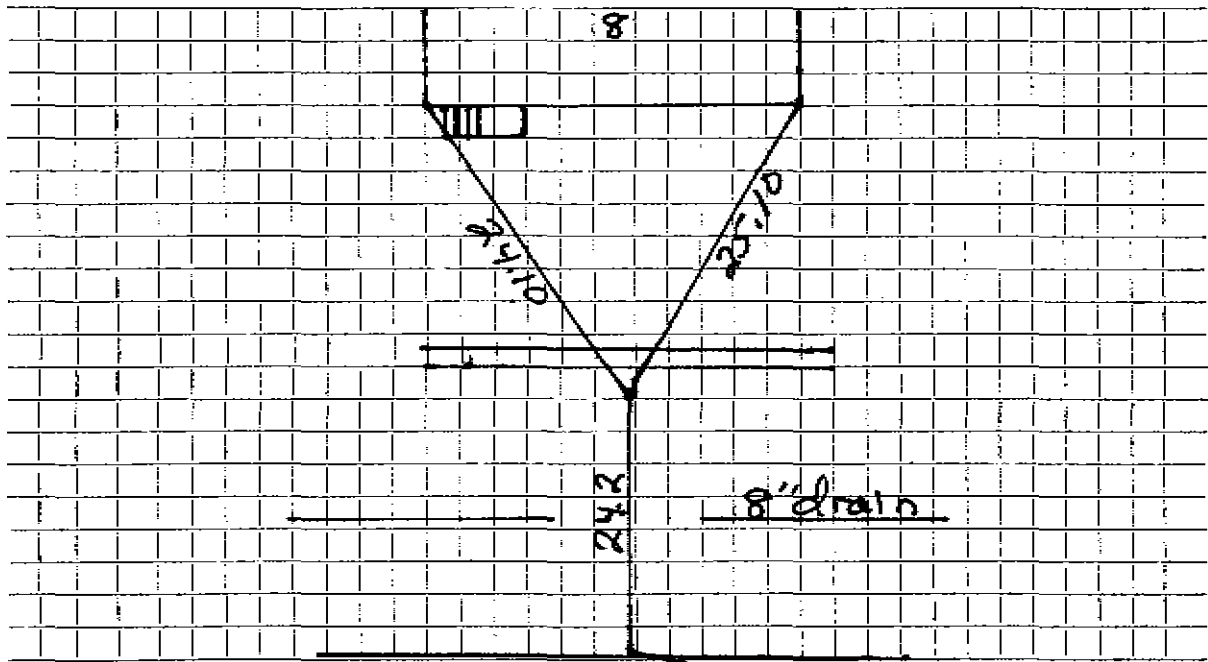

Connection made in Street. ²⁰/₁₆ Work completed 11-9-93.....

Remarks: 5'10 @ Corp...... 4" Gas..... 1' under drain.....

drain is 12.6..... From Water Main.....

Gas Service is 1' Over Water Service..... Copper is in under wall.....