

WATER SERVICE RECORD

Name Bernard C. Maloney

Service No. 69

4790

Address 12 Crescent Road

Location Lexington

~~Repair - Repair~~ New Service


Em. 7-28-52

Date	Material	Amount	Total	Date	Amount
6/4/52	Labor	8 82		4-22-52	Deposited 100 40 17 32 82 68 <u>NON CHARGE</u>
	10% Overhead	88	9 70	7-28-52	
	80' - 3/4" Copper tubing @ .3439		27 51	6/5/52	Labor
	1 - 3/4" C x 1/2 I.W.H. Stop & Waste		4 00	25' - 3/4" Copper tubing @ .3439	8 60
	1 - 3/4" C x 3/4" C. Union		3 pts. 1 72	1 - 3/4" C. Corp-Cock	4 33
	3 hrs. Littlefield Shovel		21 00	1 - 3/4" C x 3/4" C. Curb-Cock	4 67
	1 hr. trucking		75	1 Box and Rod	4 52
	patching 18 x 3		18 00	1 - 1/2 offset tail piece	50
			82 68	1 - 1/2 straight tail piece	50
				2 hrs. Littlefield Shovel	14 00
				1 hr. trucking	75
					<u>50 15</u>

TOWN OF LEXINGTON — BOARD OF PUBLIC WORKS

WATER DIVISION

Sketch of Service Here

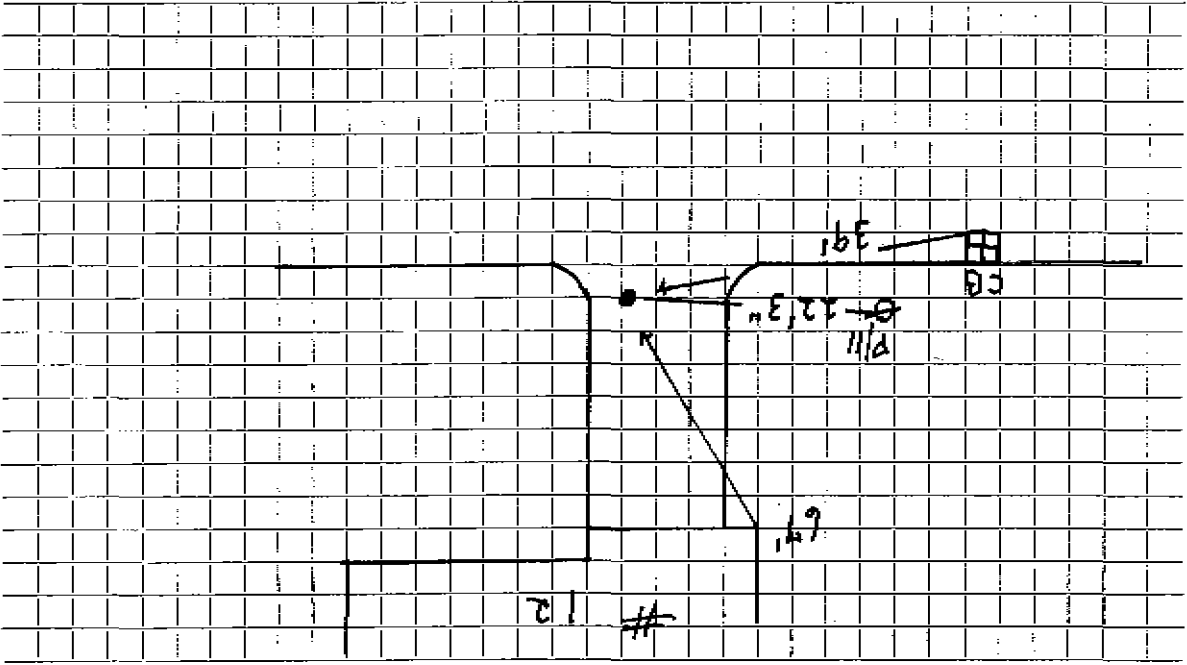

Connection made in Street Work completed

Remarks: