

WATER SERVICE RECORD

#4270

Name Simeon Demone

Service No. 237

Address 15 Crescent Road

#6929

Location Lexington, Mass.

Repair ~~XXXXXXXXXX~~ - New Service


Call 11-13-51

Date	Material	Amount	Total	Date	Material	Amount
10/9/51	Labor	4 03	4 03	9-27-51	Deposited	30 00
	10% overhead		40	11-13-51	Re-funded	3 78
	40' -3/4" copper tubing @.326		13 04		<u>NON CHARGE</u>	46 22
	1 -3/4" ex 1/2 I.W.H. stopwaste		4 00	10/9/51	Labor	5 52
	2 hrs. Littlefield shovel	7.00	14 00		16' -3/4" copper tubing @.326	5 21
	1 hr. trucking		75		1 - 3/4" C. corp-cock	4 33
	patching 10 x 3		10 00		1 - 3/4" Cx3/4" C. curb-cock	4 67
			46 22		1 box and rod	4 68
					1 - 1/2 offset tail piece	50
					1 - 1/2 straight tail piece	50
					1 hr. Littlefield shovel	7 00
					1 hr. trucking	75
						<u>33 16</u>

DATE _____

TOWN OF LEXINGTON — BOARD OF PUBLIC WORKS
WATER DIVISION

Sketch of Service Here

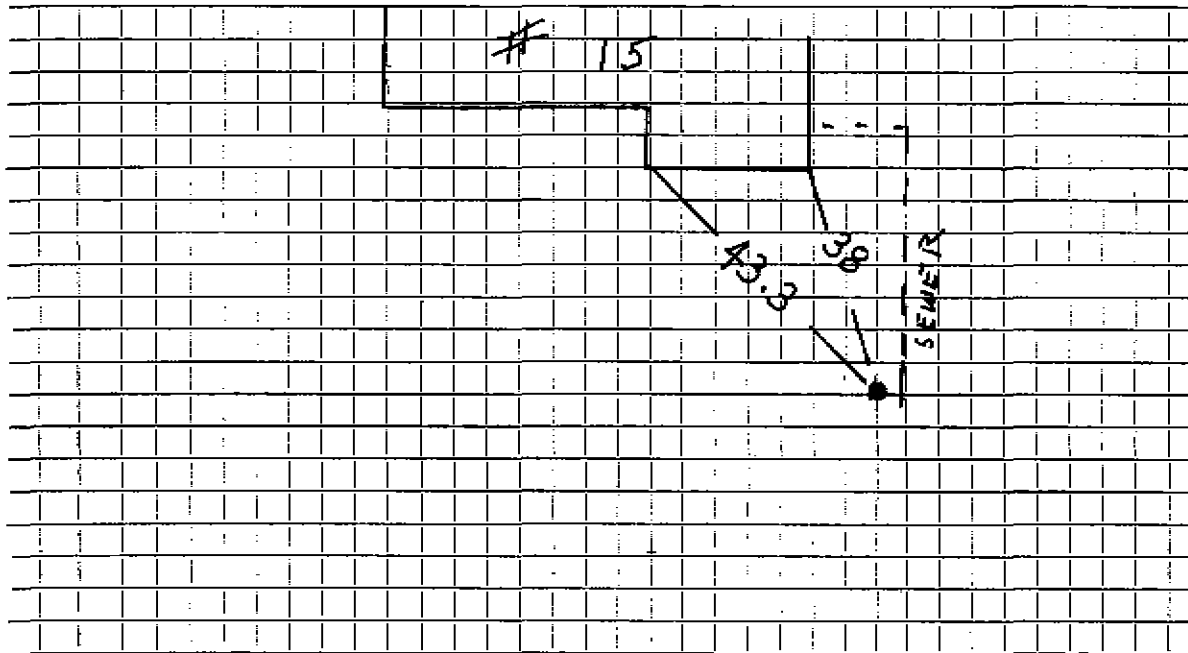

Connection made in Street. Work completed

Remarks:
.....
.....