

Name Lexington Lumber Company

Service No. 676
6181

Address - Lexington, Mass.

Location 3 Crescent Road

Kind of Pipe

Size

Size of Main

Repair—Renewal—New Service

Location

Date

Material

Amount

Total

Date

Amount

8/7/39

Service laid by owner. SEE METER ATTACHED.

Labor

Hadley Press, Inc., Lexington

DATE August 7, 1939

TOWN OF LEXINGTON—BOARD OF PUBLIC WORKS

WATER DIVISION

The undersigned applies for a supply of water at No. 3 Crescent Road St. and hereby agrees to comply with the rules and regulations as now, or at any future time, established by the Board of Selectmen.

Am't. of Estimate \$ 2.50

Owner

Lexington Lumber Co.


Am't. Paid \$ _____

Address

57 Bedford St
Lex
By Pittsford

Builder _____

Sketch of Service Here

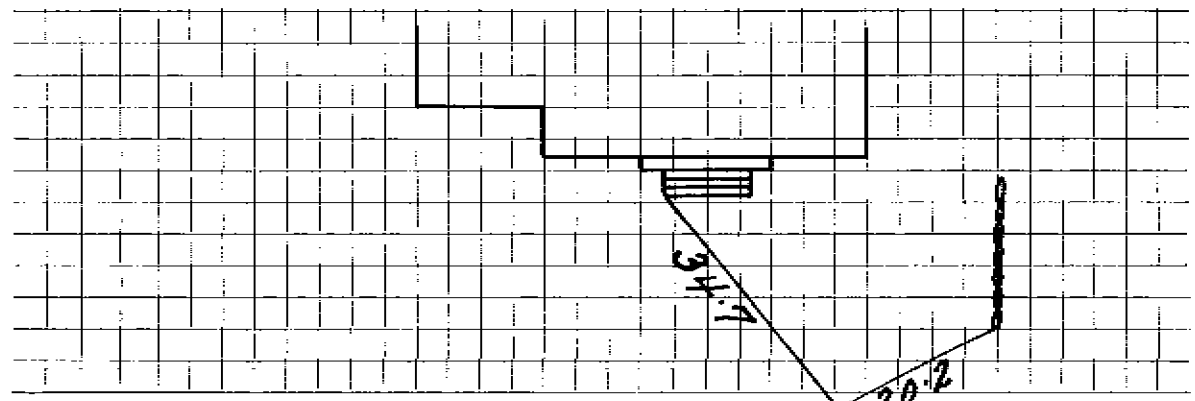

Connection made in _____ Street.

Work completed _____ 19

Remarks: