

WATER SERVICE RECORD

Name Gilbert Silvestre

Service No. 198

Address 6 Crescent Road

Location Lexington, Mass.

~~Repair~~ - New Service


Com. 11-13-51

Date	Material	Amount	Total	Date	Amount
9/29/51	Labor	5 03	5 03	<i>5-29-51</i>	<i>Disputed</i>
	10% overhead		50	<i>11-13-51</i>	<i>Refunded</i>
	40' - 3/4" copper tubing@ .326-13		04		<u>NO CHARGE</u>
	1 -3/4" Cx1/2" I.W.H.stop&waste-	4 00		9-29-51	Labor
	1 -3/4" C.x3/4" C.union (3pts.)	1 72			20'-3/4" copper tubing@.326
	2 hrs. Littlefield shovel@7.00	14 00			1 -3/4" C.curb-cock
	1 hr. trucking		75		1 - 3/4" Cx3/4" C.curb-cock
	patching 10 x 3		10 00		1 - box and rod
			49 04		1 - offset 1/2, tail piece
					1 - 1/2 straight tail piece
					1 hr. trucking
					2 hrs. Littlefield shovel@7.00
					<u>47 48</u>
				<i>Repsiv</i>	<i>outside</i>
				<i>7/12/78</i>	<i>10' 3/4 Copper</i>
					<i>1 3/4 3psvt Union</i>
					<i>1 3/4 style 88 Union</i>

DATE _____

TOWN OF LEXINGTON — BOARD OF PUBLIC WORKS
WATER DIVISION

Sketch of Service Here

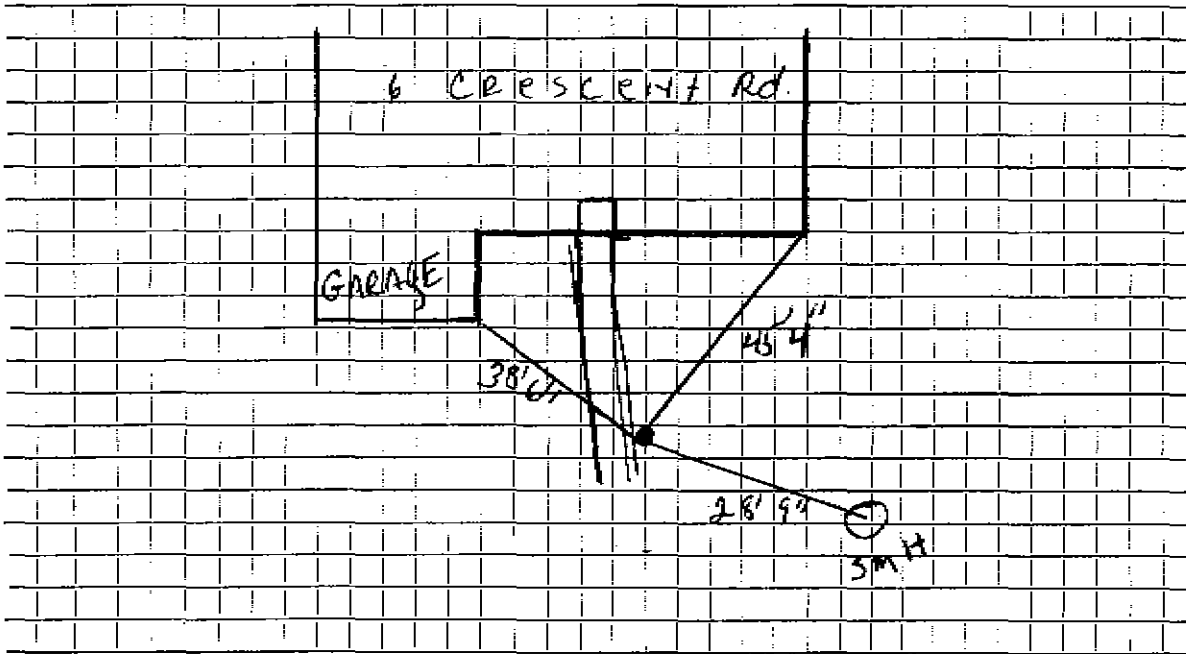

Connection made in Street. Work completed

Remarks:

.....

.....