

WATER SERVICE RECORD

Name Gilbert S. Silvestre

Service No. 404

Address 3 Crescent Road

Location

Repair ~~Renewal~~ - New Service COM. 12-31-53


Date	Material	Amount	Total	Date	Amount
12/31/53	Labor	7 27		12-23-53	Deposited 65 00
	10% overhead	72	7 89	12-31-53	Refunded 1 21
	50' - 3/4" corner tubing @ .8629	19 15			NON CHARGE 63 79
	1 - 3/4" x 6 I.W.F. stop waste	4 00		12/31/53	Labor 15 00
	2 hrs. Littlefield shovel @ 7.50	15 00			28' - 3/4" corner tubing @ .8629 9 44
	1 hr. trucking		75		1 - 3/4" S. curb-cock 4 38
	etching 13 x 8		18 00		1 - 3/4" x 3/4" S. curb-cock 4 67
			83 79		1 box end rod 3 80
					1 - straight tail pc. 50
					1 - offset tail pc. 50
					2 hrs. Littlefield shovel @ 7.50 15 00
					1 hr. trucking 75
					NON CHARGE 54 09
				7-18-78	1 3/4 COP
					1 3/4 Union

DATE _____

TOWN OF LEXINGTON — BOARD OF PUBLIC WORKS

WATER DIVISION

Sketch of Service Here

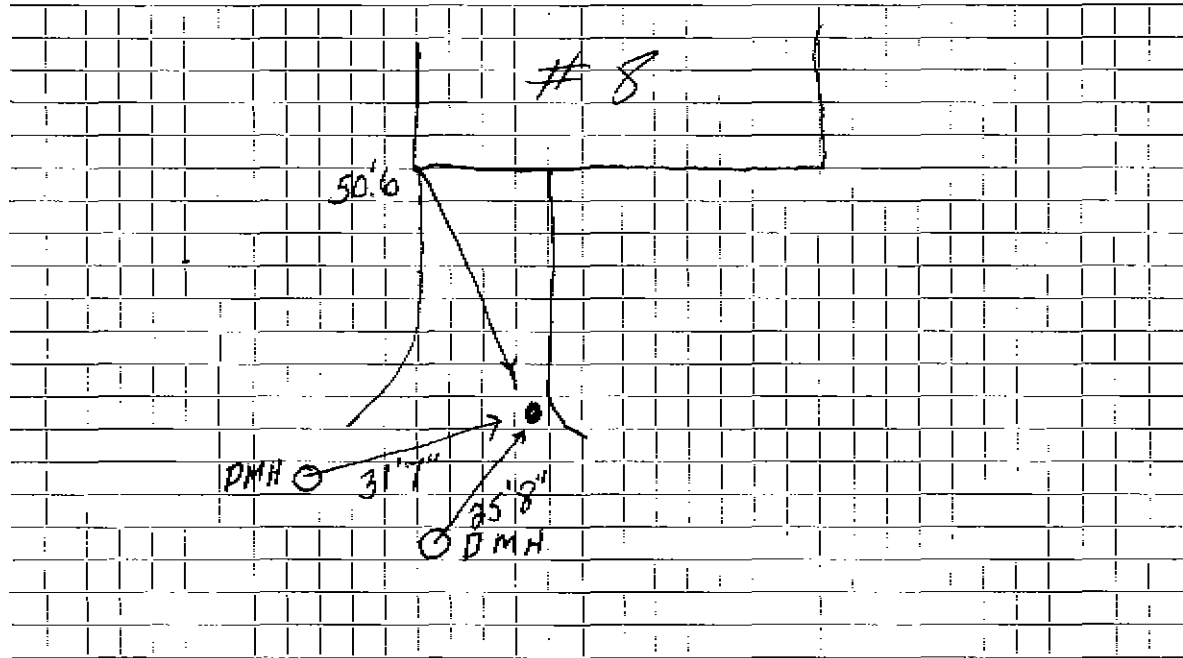

Connection made in Street. Work completed

Remarks:

.....

.....

WATER SERVICE RECORD

Name **Gilbert S. Silvestre**

Service No. **404**

Address **S Crescent Road**

Location

Repair ~~Work~~ **New Service**


COM. 12-31-53

Date	Material	Amount	Total	Date	Material	Amount
12/31/53	Labor	7 17		12-23-53	<i>Deposited</i>	63 00
	10% overhead	72	7 89	12-31-53	<i>Refunded</i>	1 21
	50' - 3/4" copper tubing @ .3629	18 15			<u>NON CHARGE</u>	62 79
	1 - 3/4" C x 1/2" I.W.H. stop & waste	4 00		12/31/53	Labor	15 00
	2 hrs. Littlefield shovel @ 7.50	15 00			26' - 3/4" copper tubing @ .3629	9 44
	1 hr. trucking	75			1 - 3/4" C. corp-cock	4 33
	catching 18 x 3		18 00		1 - 3/4" C x 3/4" C. curb-cock	4 67
			63 79		1 box and rod	3 90
					1 - 1/2" straight tail pc.	50
					1 - 1/2" offset tail pc.	50
					2 hrs. Littlefield shovel @ 7.50	15 00
					1 hr. trucking	75
					<u>Non Charge</u>	54 00
				7-18-78	1 1/4" Corp	
					1 3/4" Union	

TOWN OF LEXINGTON — BOARD OF PUBLIC WORKS
DATE

WATER DIVISION

Sketch of Service Here

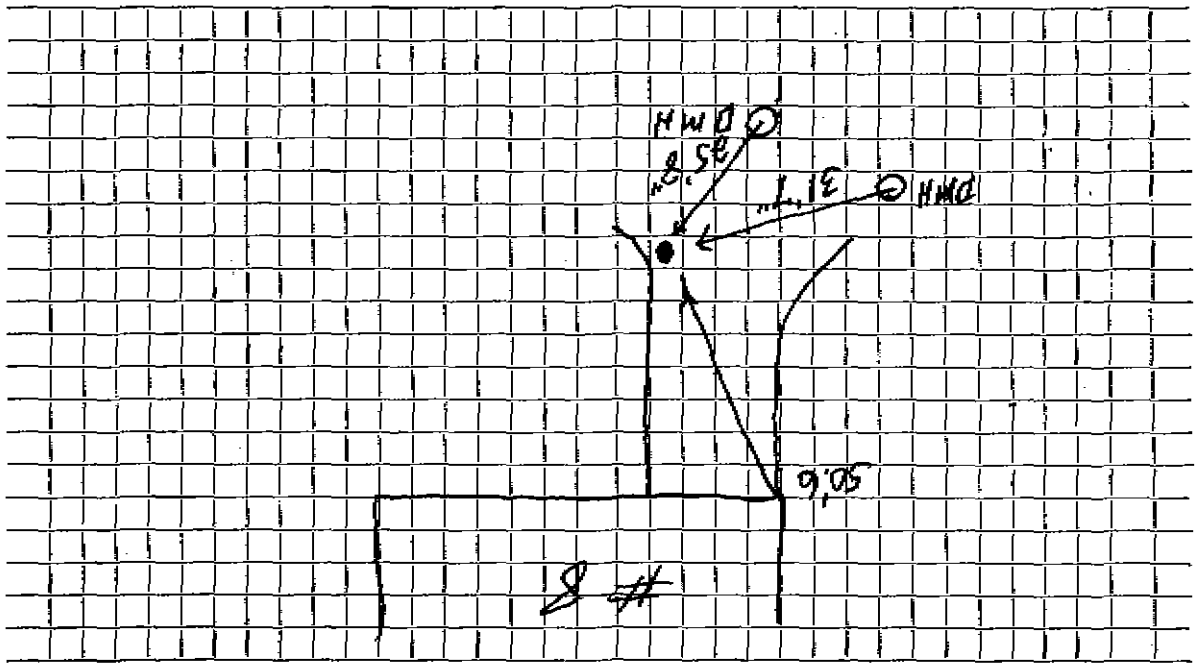

Connection made in Street. Work completed

Remarks: