

## WATER SERVICE RECORD

Name Vincent Domenichello

Service No.

103

Address 9 Crescent Road

Location Lexington Landscape Service

~~Reserve Service~~ New Service W.O. #1136

MAY 2 1966


Date	Material	Amount	Total	Date	Amount
10-20-65	Labor	35.07		9-30-65	100.00
	10% O.H.	3.51	38.58	5-2-66	15.55
	15' 3/4" Copper tubing @.42		6.30		84.45
	1 Box & Rod		4.90		
	1 Curb Cock		8.76		
	1 Corp Cock		7.41		
	9 x 3 Patch		9.00		
	1 hr Shovel		6.50		
	1 hr. Truck		3.00		
			84.45		
10-21-65	50' 3/4" Copper tubing				

DATE \_\_\_\_\_

# TOWN OF LEXINGTON — BOARD OF PUBLIC WORKS

## WATER DIVISION

Sketch of Service Here

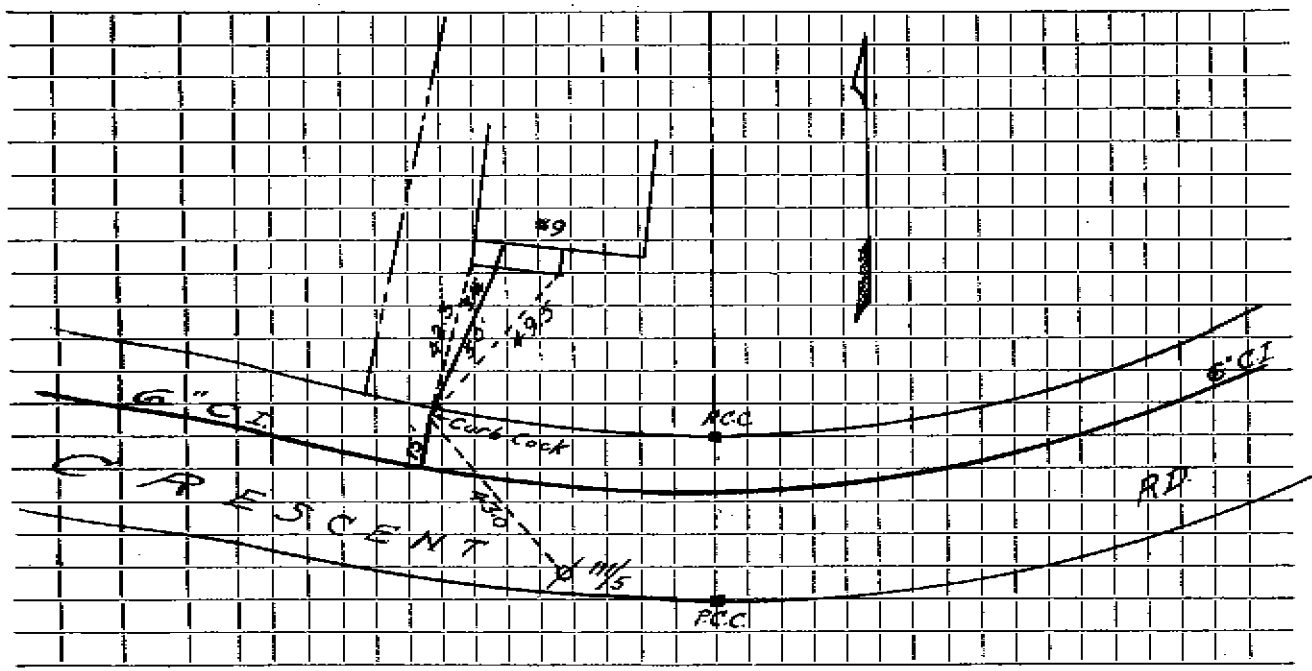

Connection made in ..... Street. Work completed .....

Remarks: .....  
.....  
.....