

Name Carsan Homes, Inc.

Service No. 281

Address 2 Cutler Farm Road

Lexington, Mass.

Location 2 Cutler Farm Road

Kind of Pipe

Size

Size of Main

~~Repair - Renewal~~ - New Service

Com. 9-5-50

Location

Date	Material	Amount	Total	Date	Amount
June 8, '50	Labor	1 30	1 30	Sept 20 '50	5 47
	10% Overhead		13		
	1 - 3/4" C x 1/2" I.W.H. S&W		3 29		
	Trucking 1 hr. @ .75		75		
			5 47		
				June 8, '50	11 90
				Labor	
				19' - 3/4" Copper Tubing @ .23	4 37
				1 - 3/4" C Corp-cock	3 15
				1 - 3/4" C Curb-cock	3 85
				1 - Box & Rod	3 35
				1 - 1/2" Offset Tail Piece	38
				1 - 1/2" Straight Tail Piece	38
				Town Shovel 1 hr. @ 3.00	3 00
				Allis Chalmers 1 hr. @ 3.00	3 00
				Trucking 1 hr. @ .75	75
					34 13
	Labor				

Bill sent 9.8.50

No Charge

Curb

5 47

11 90

4 37

3 15

3 85

3 35

38

38

3 00

3 00

75

34 13

Hidley Press, Inc., Lexington

DATE _____

TOWN OF LEXINGTON—BOARD OF PUBLIC WORKS

WATER DIVISION

The undersigned applies for a supply of water at No. _____ St. and hereby agrees to comply with the rules and regulations as now, or at any future time, established by the Board of Selectmen.

Am't. of Estimate \$ _____


Owner _____

Am't. Paid \$ _____

Address _____

Builder _____

Sketch of Service Here

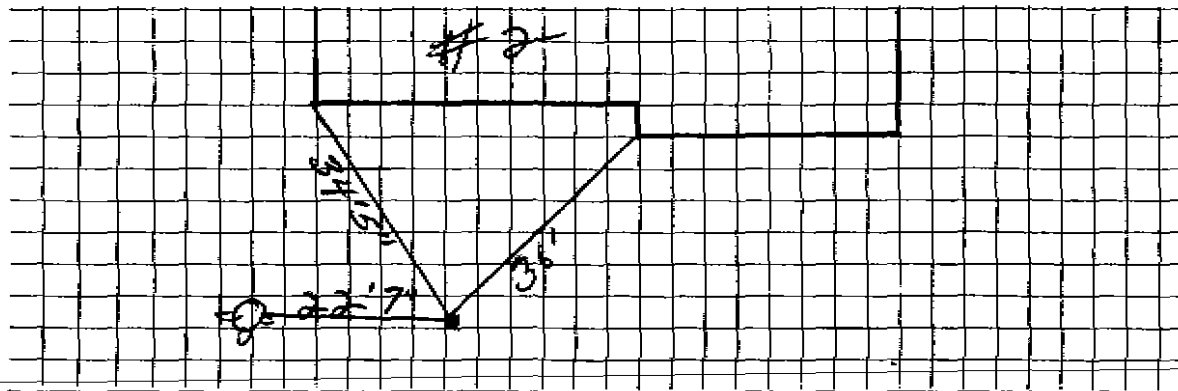

Connection made in _____ Street.

Work completed _____ 19

Remarks: