

Name Carsan Homes, Inc.

Service No. 281

Address 4 Cutler Farm Road

2232

Lexington, Mass.

Location 4 Cutler Farm Road

Kind of Pipe

Size

Size of Main

~~Repair~~ ~~Renewal~~ New Service

Com. 9-5-50

Location

Date	Material	Amount	Total	Date	Amount
June 5, '50	Labor	1 30	1 30	Sept 20 '50	5 47
	10% Overhead		13		
	1 - 3/4" C x 1/2" I.W.H. S&W		3 29		
	Trucking 1 hr. @.75		75		
			5 47		
	Pipe supplied by owner				
	<i>Bill sent 9-2-50</i>				
				June 5, '50	8 45
				16' - 3/4" Copper Tubing @.23	3 68
				1 - 3/4" C Corp-cock	3 15
				1 - 3/4" C x 3/4" C Curb-cock	3 85
				1 - Box & Rod	3 35
				1 - 1/2" Offset Tail Piece	3 8
				1 - 1/2" Straight Tail Piece	3 8
				Littlefield Shovel 1 hr. @ 7.00	7 00
				Trucking 1 hr. @.75	75
	Labor				30 99

Paid

No Charge

TOWN OF LEXINGTON — BOARD OF PUBLIC WORKS

WATER DIVISION

The undersigned applies for a supply of water at No. _____ St. and hereby agrees to comply with the rules and regulations as now, or at any future time, established by the Board of Selectmen.

Am't. of Estimate \$ _____


Owner _____

Am't. Paid \$ _____

Address _____

Builder _____

Sketch of Service Here

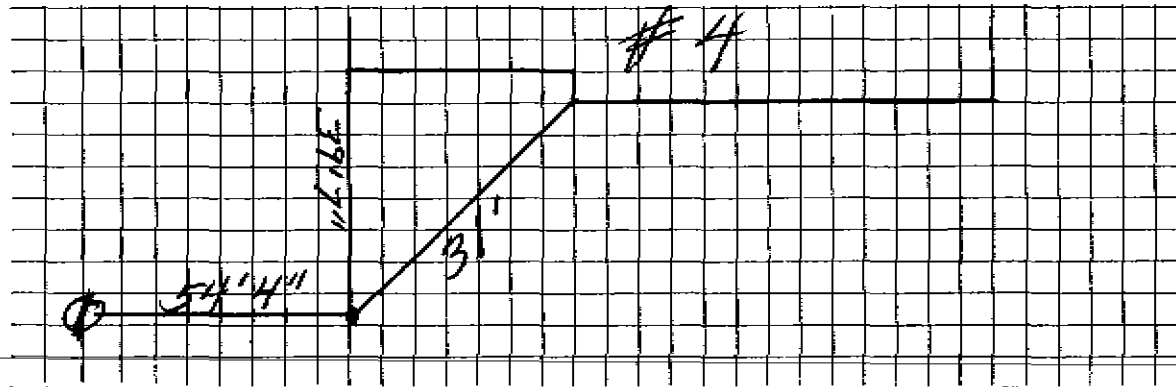

Connection made in _____ Street.

Work completed _____ 19__

Remarks: