
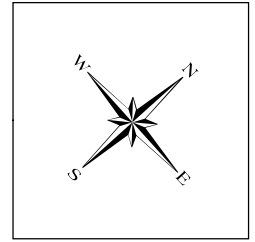


Water Service Tie Card
TOWN OF LEXINGTON

5 Cutler Farm Road

MASSACHUSETTS

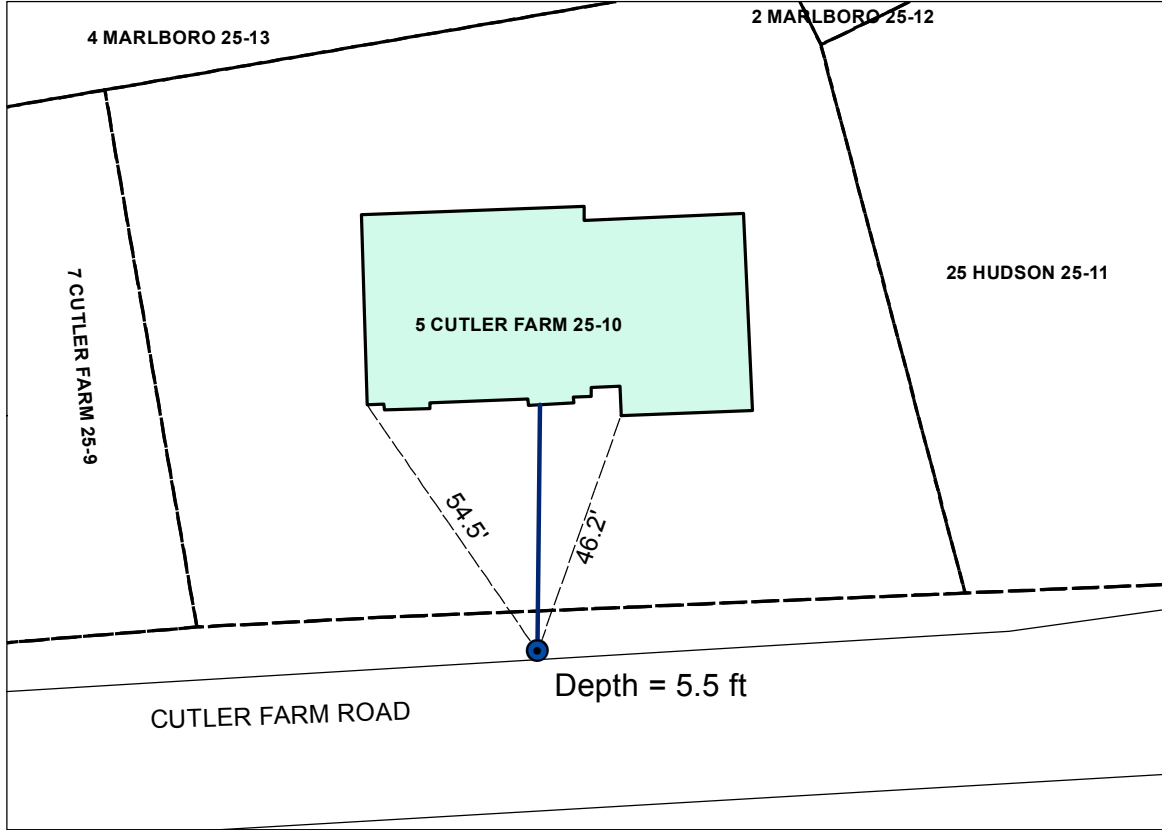

Legend	
	Curb Stop
	Ties_Dimensions
	Water Service Line
	Property Line

Address	Map and Lot	Permit Number	Contractor Name	Inspector
5 Cutler Farm Road	25-10	5521	Santangelo	D. Pavlik

Date: 1/17/14	Material	Amount
	3/4" Copper	18 inches off of existing curb stop
	1" x 3/4" fitting	
	1" Copper	7 inches to 1" curb stop
	1" Curb Stop	
	1" Copper type "k"	39.2 Feet

Type of work completed
 New 1" water service to house from curb stop. New house built - old house removed on existing lot.