


DATE 9/2017

TOWN OF LEXINGTON — BOARD OF PUBLIC WORKS

WATER DIVISION

Sketch of Service Here

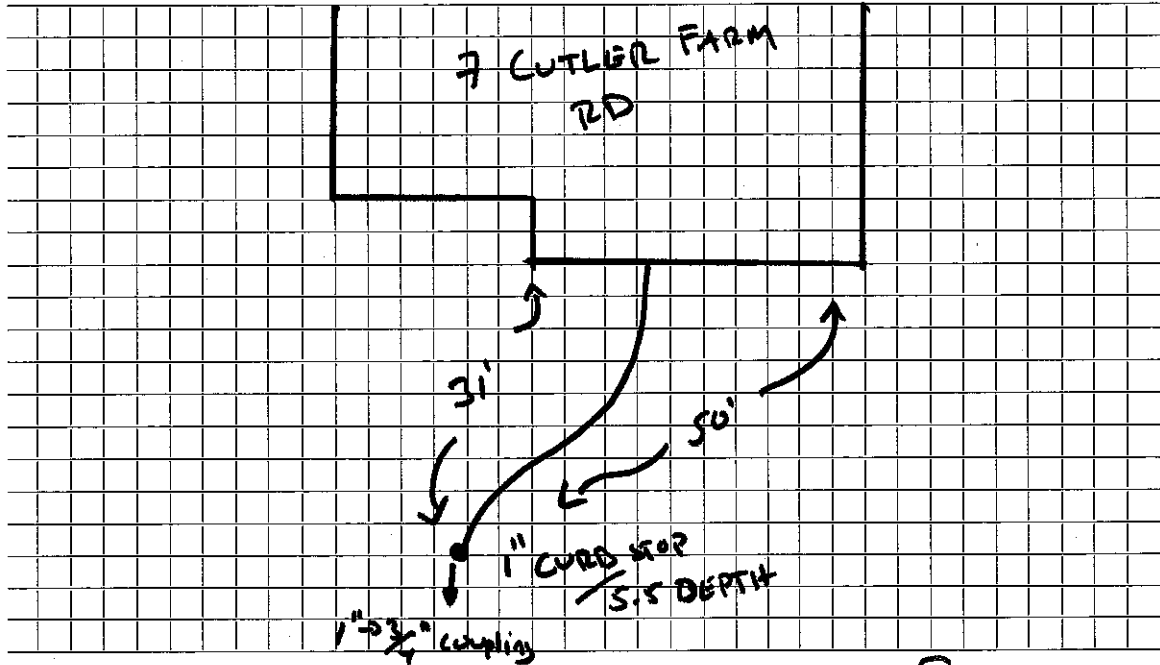

Connection made in Street. Work completed FINNICK AN

Remarks: ... OLD CURB (3/4") LEFT ON, DURIND