

Name Carsen Homes, Inc.
 Address 8 Cutler Farm Road
 Lexington, Mass.

Service No.

#4392
 281

Location 8 Cutler Farm Road

Kind of Pipe

Size

Size of Main

~~Repair-Renewal~~ New Service

Com. 9-5-50

Location

Date	Material	Amount	Total	Date	Location	Amount
June 5, 50	Labor	1 30	1 30			5 47
	10% Overhead		13			
	1 - 3/4" C x 1/2" I.W.H. S&W		3 29		No Charge	
	Trucking 1 hr. @ .75	.75	75	June 5, 50	Labor	8 45
			5 47	17'	- 3/4" Copper Tubing @.23	3 91
				1 - 3/4" C	Corp-cock	3 15
				1 - 3/4" C x 3/4" C	Curb-cock	3 85
				1 - Box & Rd		3 35
				1 - 1/2" Offset	Tail Piece	38
				1 - 1/2" Straight	Tail Piece	38
				Littlefield	Shovel 1 hr. @ 7.00	7 00
				Trucking 1 hr. @ .75		75
	Labor					31 22

Hadley Press, Inc., Lexington

DATE _____

TOWN OF LEXINGTON—BOARD OF PUBLIC WORKS

WATER DIVISION

The undersigned applies for a supply of water at No. _____ St. and hereby agrees to comply with the rules and regulations as now, or at any future time, established by the Board of Selectmen.

Am't. of Estimate \$ _____


Owner _____

Am't. Paid \$ _____

Address _____

Builder _____

Sketch of Service Here

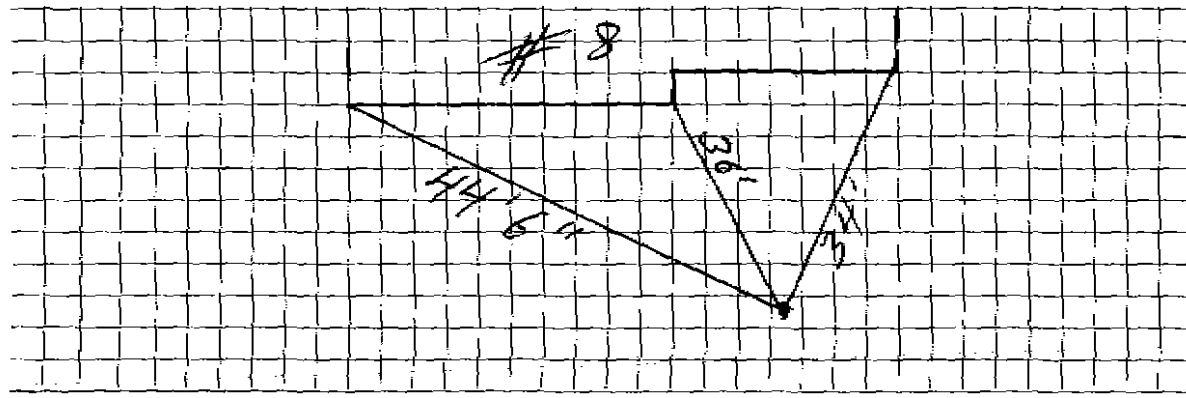

Connection made in _____ Street. Work completed _____ 19__

Remarks: