




WATER DIVISION

Sketch of Service Here

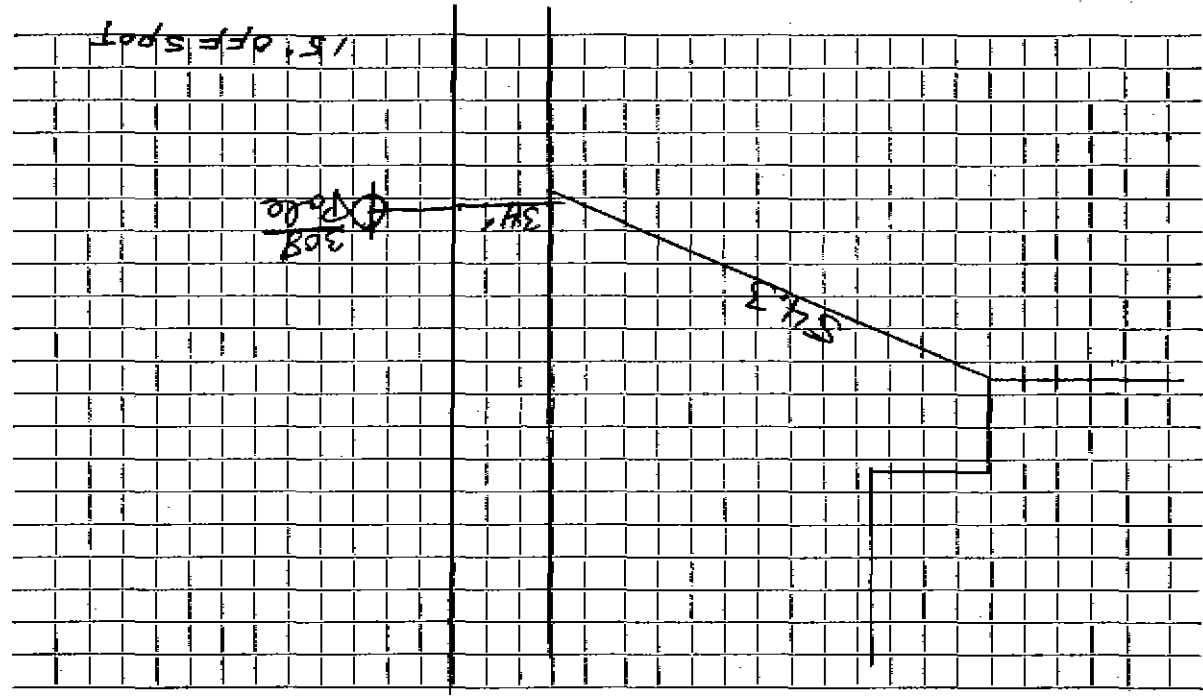

Connection made in \_\_\_\_\_  
Remarks: \_\_\_\_\_

15  
3-25