

WATER SERVICE RECORD

Name Custom Colonials

Service No. 67-3126

Address 101 110 Dane Road # 11 DANE RD.

Location Lot 208

REPAIR ~~REPAIR~~ - New Service


Comm 6-22-59

Date	Material	Amount	Total	Date	Amount
5-1-59	Labor	3.90		4-21-59	25 00
	10% O.H.	.38	4.18	6-22-59	6.68
60'	3/4" Copper tubing @.3666		22.00	8-17-59	1.09
1	3/4" C x 1/2 I.W.H. Stop & Waste	5.84			<u>NON CHARGE</u>
1	hr. Trucking @.75	.75	32.77	5/3/57	Labor 4 29
					24' 3/4" Copper tubing @.4228 10 15
					1 3/4" C Corp Cock 4 64
					1 3/4" C Curb Cock 5 94
					1 Box & Rod 4 62
					1 Hr. trucking @.75 75
					<u>30 39</u>
					1 1/2 Straight tailpiece .60
					1 1/2 Offset tailpiece .50
					1 Box & Rod 5.00
					<u>36.39</u>
				Bill sent 6-22-59	1.09

TOWN OF LEXINGTON — BOARD OF PUBLIC WORKS  
DATE \_\_\_\_\_

**WATER DIVISION**

Sketch of Service Here

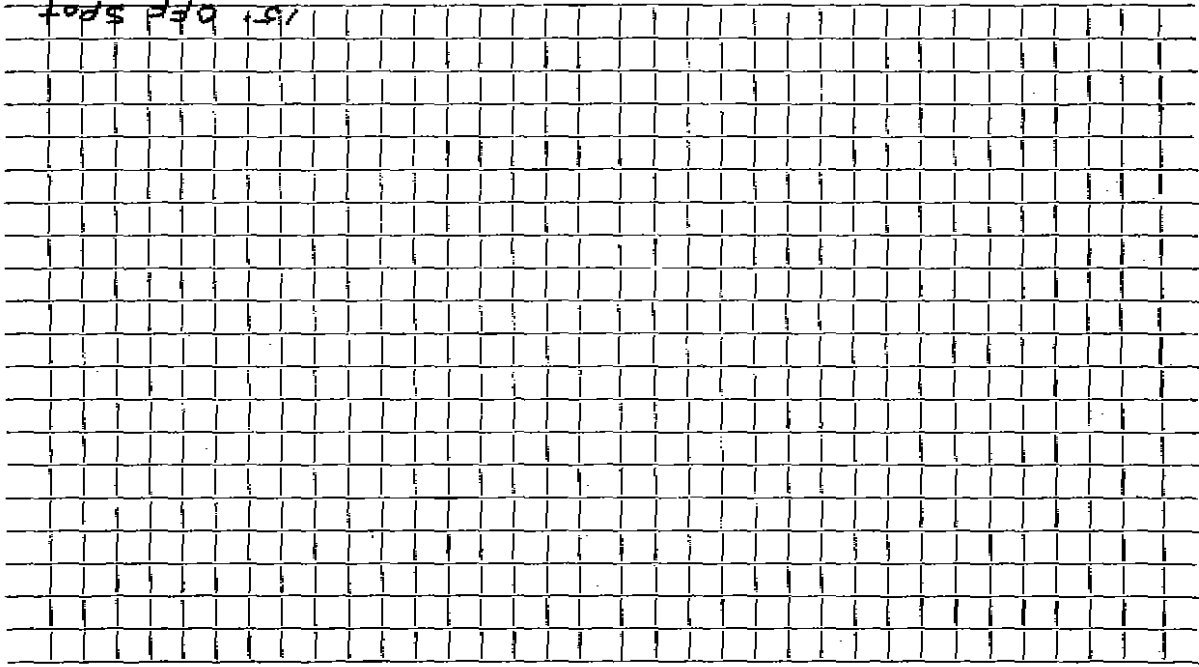

15

Connection made in .....

Street.....

Work completed .....

Remarks: .....