


**Water Service Tie Card**  
**TOWN OF LEXINGTON**  
 MASSACHUSETTS

**12 Dane Rd**

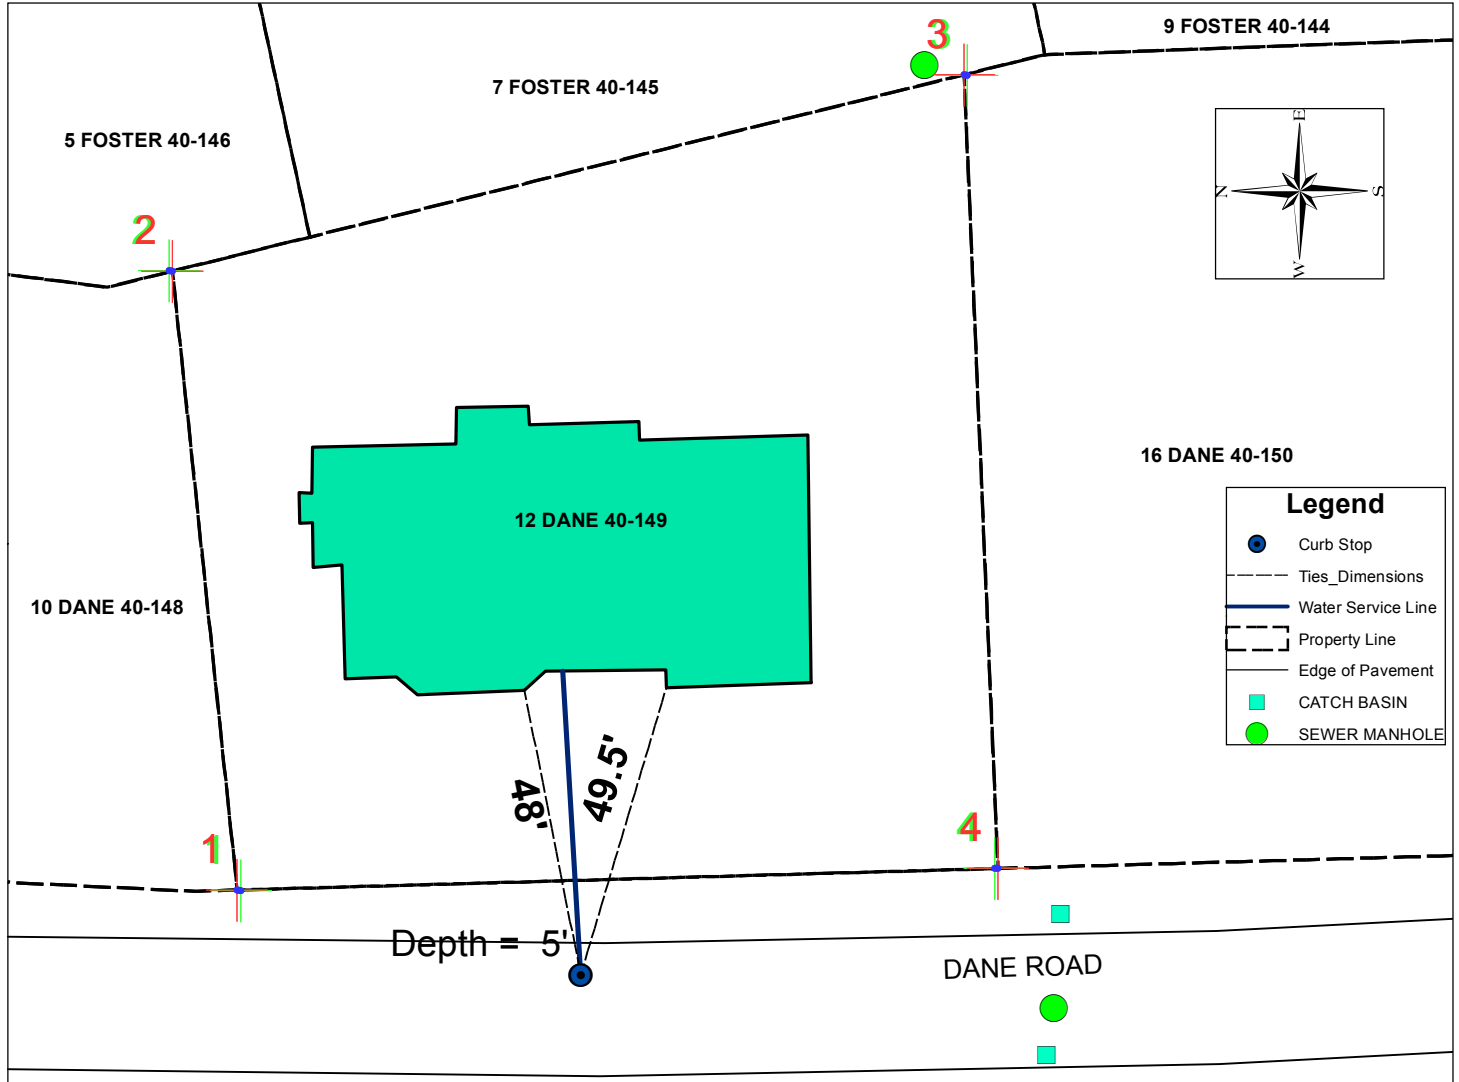

Address	Map and Lot	Permit Number	Contractor Name	Inspector
12 Dane Rd	40-149	6039	G. Henderson Co. Inc	msprague
Date	Material	Depth of Cover	Amount	
1/5/2015	Corporation	5 ft	1	
	1" Curb Valve and Buffalo Box	4 ft	1	
	1" Copper type "k"		34.5 ft to HSE	
<b>Type of work completed</b>				
Repair and replace water line from house to curb and to main.				