


DATE _____

TOWN OF LEXINGTON — BOARD OF PUBLIC WORKS

WATER DIVISION

Sketch of Service Here

15'

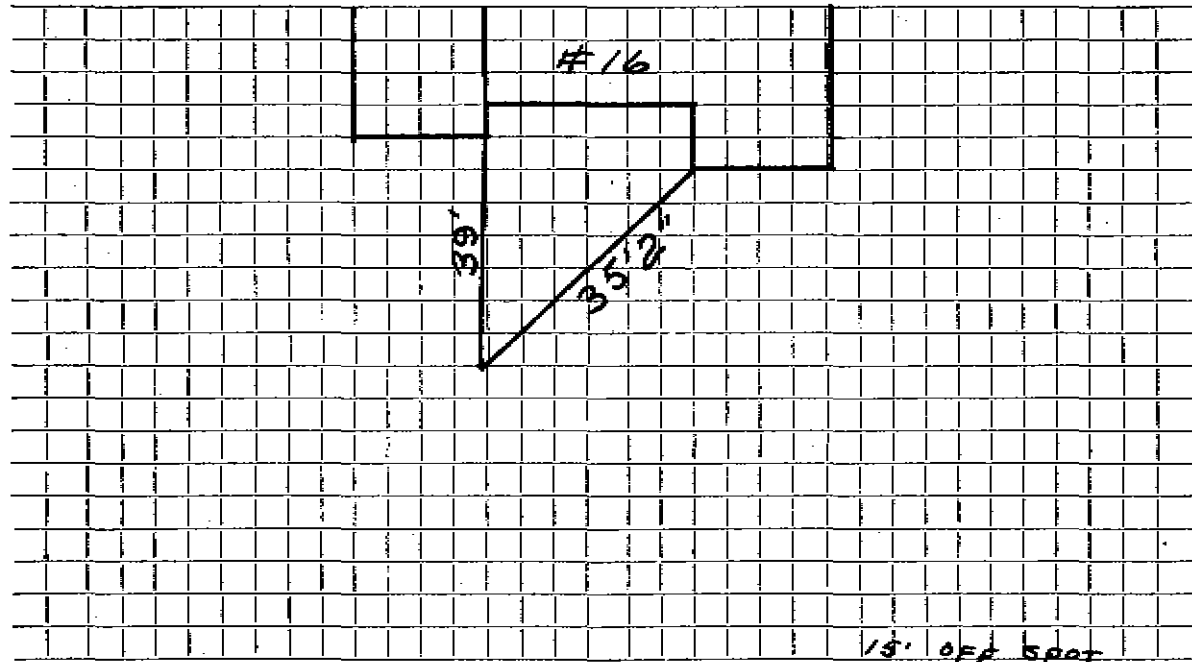

15' off spot

Connection made in Street. Work completed

Remarks:
.....
.....