

WATER SERVICE RECORD

Name A. LaFauci & SonService No. 139Address Lot 205 Dane Road # 19 DANE RD.

Location


~~Repair~~ ~~Renewal~~ New ServiceComm 11-14-58

Date	Material	Amount	Total	Date		Amount
7/23/58	Labor	3 71		7-17-58	Deposit	25 00
	10% Overhead	37	4 08	11-24-58	Pay 540# 125	47
	40'-3/4" Copper tubing @.37		14 80			25 47
	1-3/4" C x 1/2 IWH stop & waste		5 84		<u>NON CHARGE</u>	
	1 hr. Trucking @.75		75	5/3/57	Labor	4 29
			25 47		26'3/4" Copper tubing	11 15
					1 3/4" C Corp Cock	4 64
					1 3/4" C Curb Cock	5 94
					1 Box & Rod	4 62
					1 Hr. trucking @.75	75
						31 39
				7/23/58	1-1/2" straight tailpiece	50
					1-1/2" offset tailpiece	50
					1 Box & Rod	5 00
						37 39

TOWN OF LEXINGTON — BOARD OF PUBLIC WORKS
WATER DIVISION

Sketch of Service Here

15

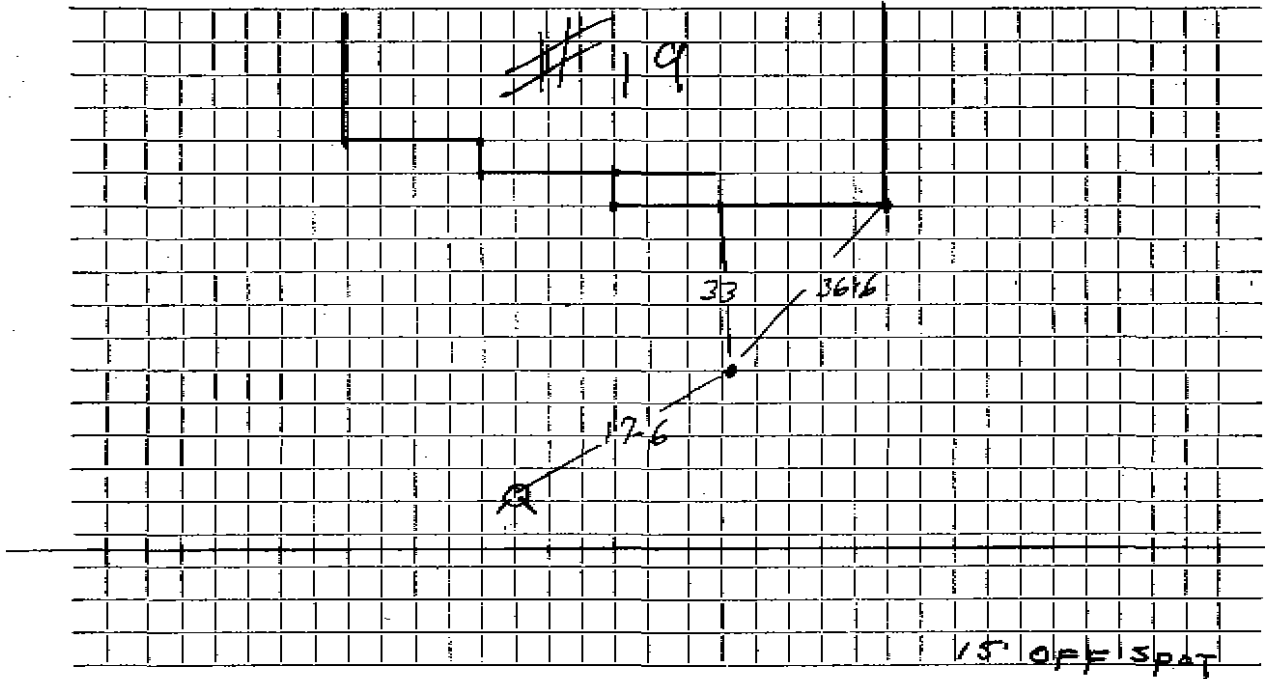

Connection made in Street. Work completed

Remarks:
.....
.....