

WATER SERVICE RECORD

#4885 642

Name Louis Ciampa

Service No. 167

Address #252 Dana Road

Location Lot #202

Reports: ~~RENEWAL~~ New Service

Comm 9-19-60

Date	Material	Amount	Total	Date	Amount
8-25-60	Labor	1.94		8-15-60	Deposit 50.00
	10% O.H.	.19	2.13	9-19-60	Refund 21.90
40'	3/4" Copper tubing @.42		16.80		25.10
1	3/4" C x 1/2" I.W.H. Stop & Waste		6.17		<u>NON CHARGE</u>
			25.10	5/4/57	Labor 4.29
					24' 3/4" Copper tubing @.4228 10.15
					1 3/4" C Corp Cock 4.64
					1 3/4" C Curb Cock 5.94
					1 Box & Rod 4.62
					1 3/4" Union (3 part) 2.27
					<u>31.91</u>
					1 1/2 Straight tailpiece .50
					1 1/2 Offset tailpiece .50
					<u>32.91</u>


DATE _____

TOWN OF LEXINGTON — BOARD OF PUBLIC WORKS

WATER DIVISION

Sketch of Service Here

15-

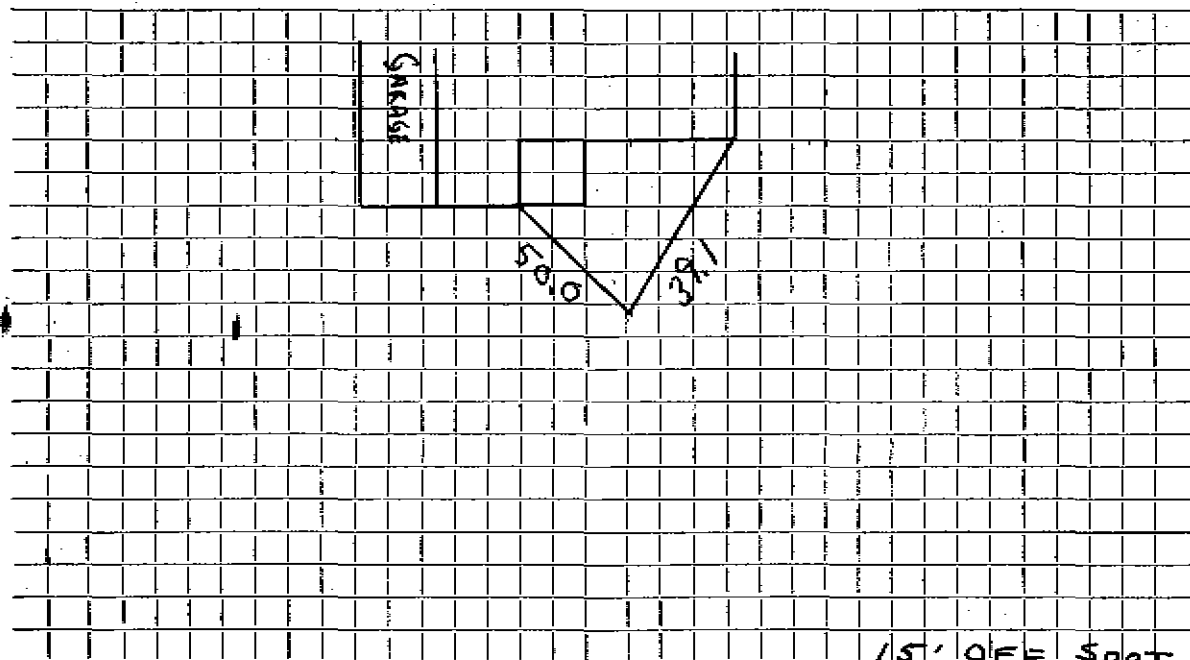

Connection made in Street. Work completed

Remarks:

.....

.....