

WATER SERVICE RECORD

3027

Name Nicholas DeBonis

Service No. 243

Address 185 260 Dane Road

Location Lot #220

~~Repair/Renewal~~—New Service

Comm 12-12-60


Date	Material	Amount	Total	Date	Amount
11-16-60	Labor	1 94		10-30-60	25 00
	10% O.H.	19	2 13	12-12-60	41 50
	60' 3/4" Copper tubing @42		25 20		33 50
	1 3/4" Cx 1/2 I.W.H. Stop&Waste		6 17		NON CHARGE
			33 50	5/3/57	Labor 4 28
					36' 3/4" Copper tubing @.4228 15 22
					1 3/4" C Corp Cock 4 64
					1 3/4" C Curb Cock 5 94
					1 Box & Red 4 62
					1 Hr. trucking @.75 75
					35 45
					1 1/2 Straight tailpiece 50
					1 1/2 Offset tailpiece 50
					36 45

TOWN OF LEXINGTON — BOARD OF PUBLIC WORKS

WATER DIVISION

Sketch of Service Here

15

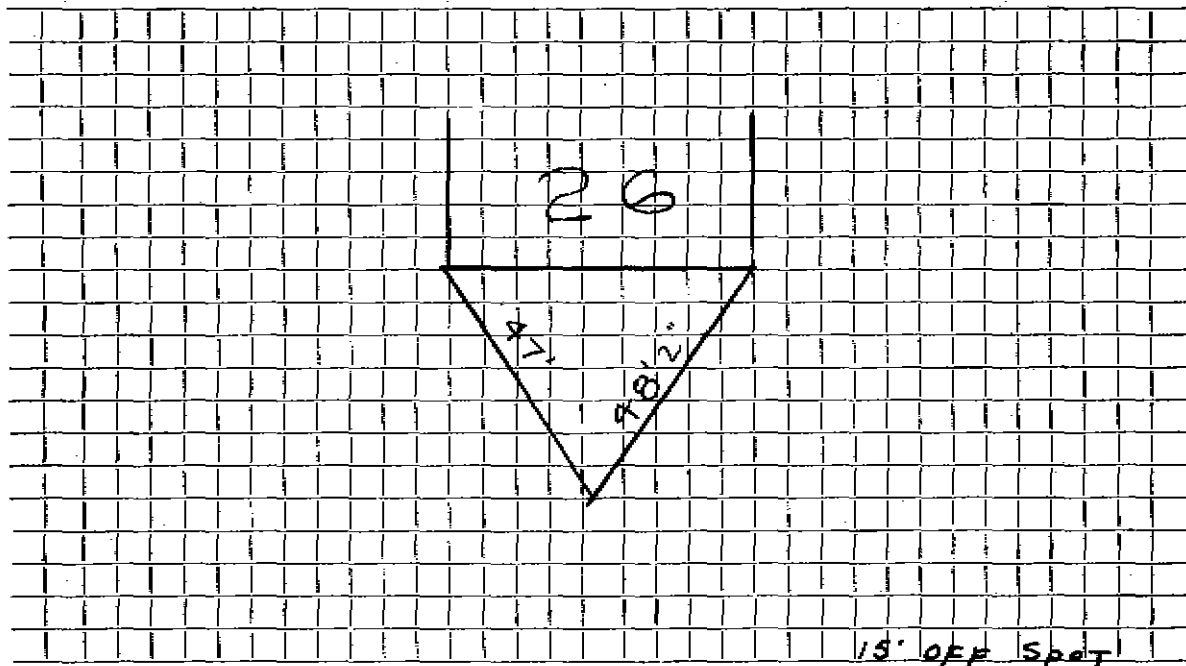

Connection made in Street. Work completed

Remarks:

.....
.....