

WATER SERVICE RECORD

Name Colonial Contractor's & Builders, Inc.

Service No. 289

Address 27 Dana Road Lot 201 Dana Road

7618

Location

~~Water~~ ~~Water~~ - New Service

Comm 5-4-59


Date	Material	Amount	Total	Date	Amount
4-9-59	Labor	2 01		12-31-59	Deposit 35 00
	10% O.H.	20	2 21	5-4-59	Refund 9 34
46'	3/4" Copper Tubing @.3666		16 86		25 64
1	3/4" C x 1/2 I.W.H. Stop & Waste		5 84		NON CHARGE
1	Hr. Trucking @.75		75	5-3-57	Labor 4 28
			25 66	16'	3/4" Copper Tube @.4228 6 76
				1	3/4" C Corp Cock 4 64
				1	3/4" C Gurb Cock 5 94
				1	Box & Rod 4 62
				1	Hr. Trucking @.75 75
					26 99
				4-9-59	1 1/2 Straight Tailpiece 50
					1 1/2 Offset Tailpiece 50
					27 99

DATE _____

TOWN OF LEXINGTON — BOARD OF PUBLIC WORKS

WATER DIVISION

Sketch of Service Here

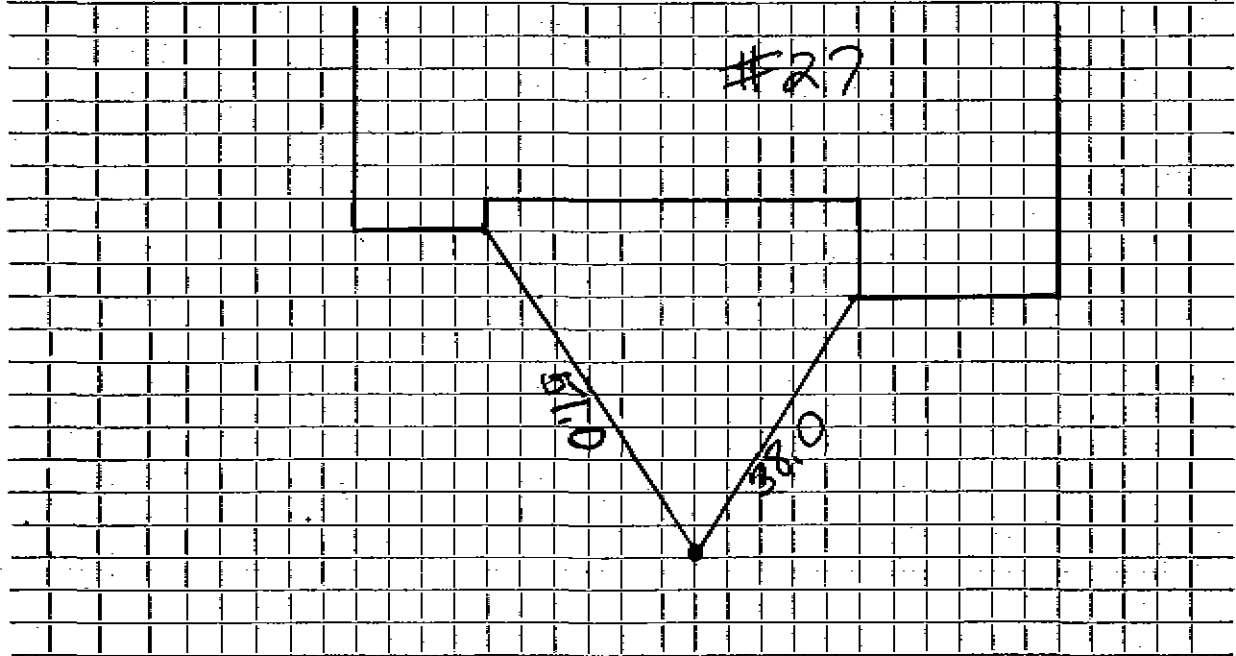

Connection made in Street. Work completed

Remarks:
.
.