

Name Earl J. Boyd

Address 3 Dane Road

Lexington, Mass.

1300

Service No. 206

#7056

Location 3 Dane Road

Kind of Pipe

Size

Size of Main

~~Repair~~ ~~Renewal~~ - New Service

Com. 11-8-49

Location

Date	Material	Amount	Total	Date	Amount
Oct. 17, '49	Labor	3 75	3 75	Oct 4 '49	40 00
	10% Overhead		38	11. 18 / 11	
	42' - 3/4" Copper Tubing @.24		10 08		33 64
	1 - 3/4" C x 3/8" I.W.H. S&W		3 29		
	1 - 3/4" C x 3/4" C Union (3pts)		1 39	Oct. 17, '49	3 75
	Littlefield Shovel 2 hrs. @7.00		14 00	26' - 3/4" Copper Tubing @.24	6 24
	Trucking 1 hr. @.75		75	1 - 3/4" C Corp-cock	3 15
			33 64	1 - 3/4" C x 3/4" C Curb-cock	3 85
				1 - Box & Rod	3 75
				1 - 1/2" Offset Tail Piece	37
				1 - 1/2" S traight Tail Piece	37
				Littlefield Shovel 1 hr. @ 7.00	7 00
				Trucking 1 hr. @.75	75
	Labor				29 23

Deposited
No Charge

DATE _____

TOWN OF LEXINGTON - BOARD OF PUBLIC WORKS

WATER DIVISION

The undersigned applies for a supply of water at No..... St. and hereby agrees to comply with the rules and regulations as now, or at any future time, established by the Board of Selectmen.

Am't of Estimate \$.....

Owner


Am't Paid \$.....

Address

Builder

.....

Sketch of Service Here

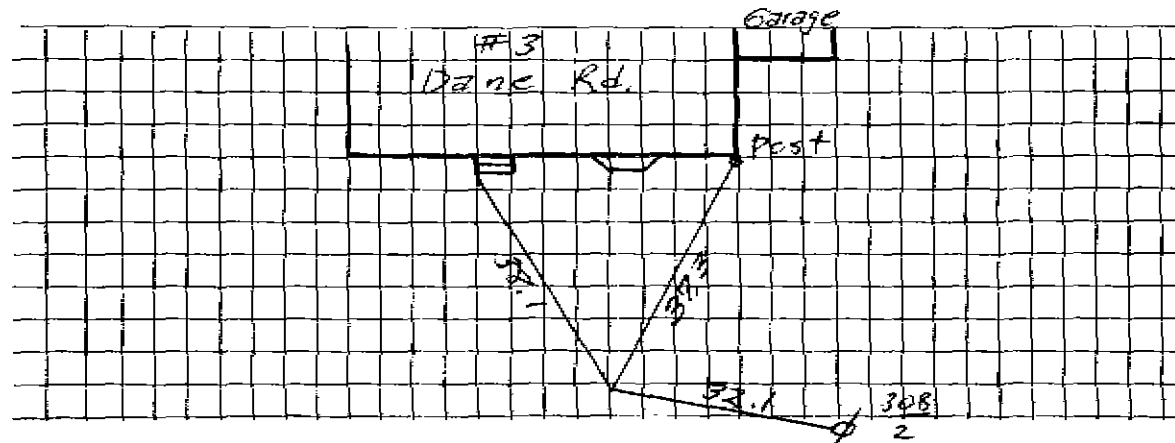

Connection made in Street.

Work completed19

Remarks: