

WATER SERVICE RECORD

Name Herbert Rhodes

Service No. 98

Address 5 Dane Road

Location Lexington, Mass.

~~Repair - Renewal~~ - New Service


Com. 8-6-51

Date	Material	Amount	Total	Date	Material	Amount
6-1-51	Labor	6 23	6 23	11, 24, 25, 26, 27, 28, 29, 30, 31, 1951	<i>Subtotal</i>	50 00
	10% Overhead		62			7 19
	45' - 3/4" Copper Tubing @ .326	14 67			No Charge	14 27
	1 - 3/4" O x 1/2" I.W.E. S&W	1 00	14 00	6-2-51	Labor	6 24
	Littlefield Shovel 2 hrs. @ 7.00	14 00	14 00		27' - 3/4" Copper Tubing @ .326	8 80
	Trucking 1 hr. @ .75	75	75		1 - 3/4" Corp-cock	4 33
			40 27		1 - 3/4" x 3/4" Curb-cock	4 57
					1 - Box & Rod	4 68
					1 - 1/2" Offset Tail Piece	50
					1 - 1/2" Straight Tail Piece	50
					Littlefield Shovel 2 hrs. @ 7.00	14 00
					Trucking 1 hr. @ .75	75
						45 19

DATE _____

TOWN OF LEXINGTON — BOARD OF PUBLIC WORKS
WATER DIVISION

Sketch of Service Here

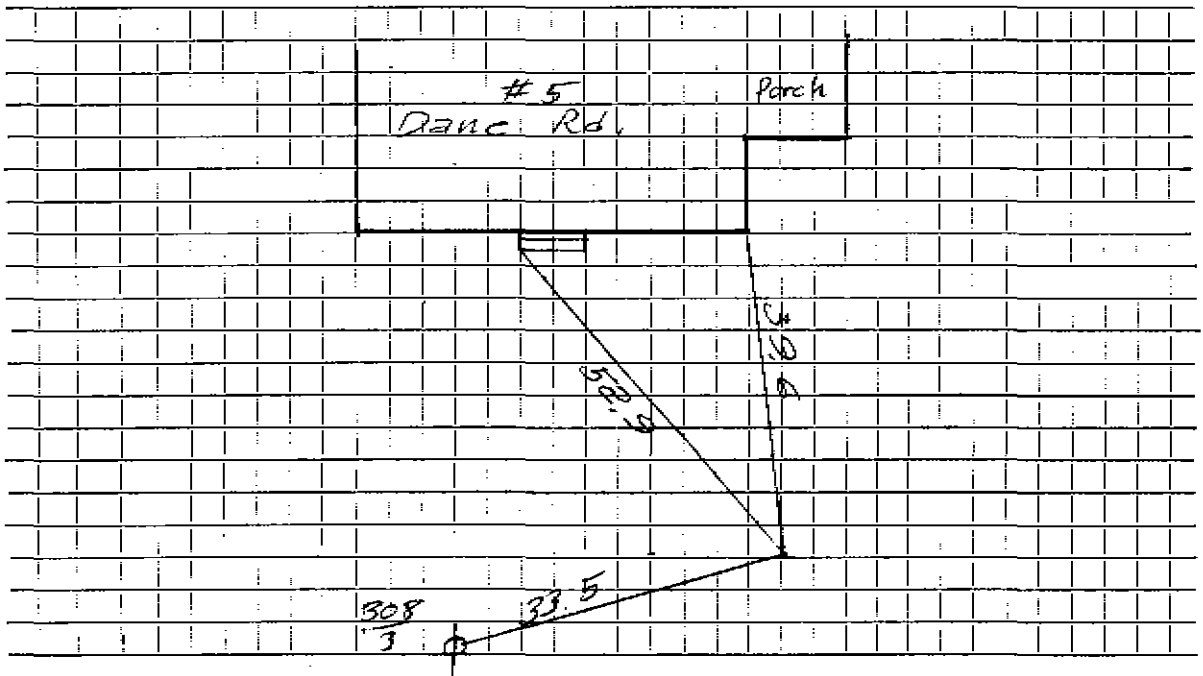

Connection made in Street. Work completed

Remarks:
.....
.....