

Name Harry Johnson (Check from : Eric G. Sahlberg  
 Address 50 Brighton Street 7 Frost St., Camb.  
 Belmont, Mass. #12

Service No. ~~38~~ 712  
 # 2821 # 5232

Location Lot 16 Daniels Street

Kind of Pipe Size Size of Main  
 Repair—Renewal—New Service Location

Date 1938	Material	Amount	Total	Date	Amount
3/19/38	2 hrs. @ 60¢	1 20	1 20	May 12, 1938 Deposited	16 50
	38' 3/4" C. Tubing @ 20¢		7 60		
	1 3/4" Bushing		30		
	1 3/4" S. & W.		3 75		
	2 hrs. Trucking @ 75¢		1 50		
			<u>14 35</u>		
	Flat Rate:		\$16 50		
	Labor				

Hadley Press, Inc., Lexington

DATE July 9-37

TOWN OF LEXINGTON—BOARD OF PUBLIC WORKS

**WATER DIVISION**

The undersigned applies for a supply of water at No. Lat 16 Daniels St. and hereby agrees to comply with the rules and regulations as now, or at any future time, established by the Board of Selectmen.

Am't. of Estimate \$ \_\_\_\_\_

Owner Harry G. Johnson


Am't. Paid \$ \_\_\_\_\_

Address 50 Brighton St

Builder \_\_\_\_\_

Brimont  
by Eric G. Sahlberg

Sketch of Service Here

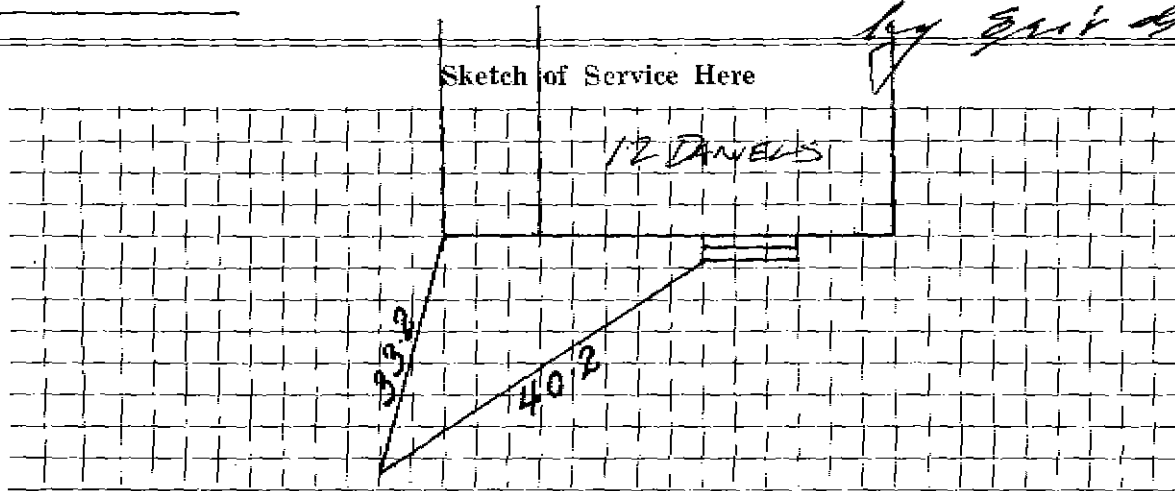

Connection made in \_\_\_\_\_ Street.

Work completed \_\_\_\_\_ 19

Remarks: