

Name Harry Johnson (Paid by Eric G. Sahlberg  
 Address 50 Brighton Street  
 Belmont, Mass.

Service No. ~~22~~ 711  
 2869

Location Lot 15 Daniels Street

Kind of Pipe

Size

Size of Main

Repair—Renewal—New Service

Location

Date 1938	Material	Amount	Total	Date	Location	Amount
5/27/38	2 hrs. @ 60¢	1 20	1 20	June 1, 1938	Deposited	15 50
	31' 3/4" Copper Tubing @ 20¢		6 20			
	1 3/4" S. and W.		3 75			
	1 3/4" x 1/2" Bushing		30			
			<u>11 45</u>			
	Flat Rate:					
	31' @ 50¢	\$15 50				
	Labor					

Hadley Press, Inc., Lexington

DATE July 9-37

TOWN OF LEXINGTON - BOARD OF PUBLIC WORKS  
WATER DIVISION

The undersigned applies for a supply of water at No. 415 Daniels St. and hereby agrees to comply with the rules and regulations as now, or at any future time, established by the Board of Selectmen.

Am't. of Estimate \$ \_\_\_\_\_

Owner Kerry E Johnson


Am't. Paid \$ \_\_\_\_\_

Address 50 Brighton St

Builder \_\_\_\_\_

Bilman  
By Eric E. Sabatney

Sketch of Service Here

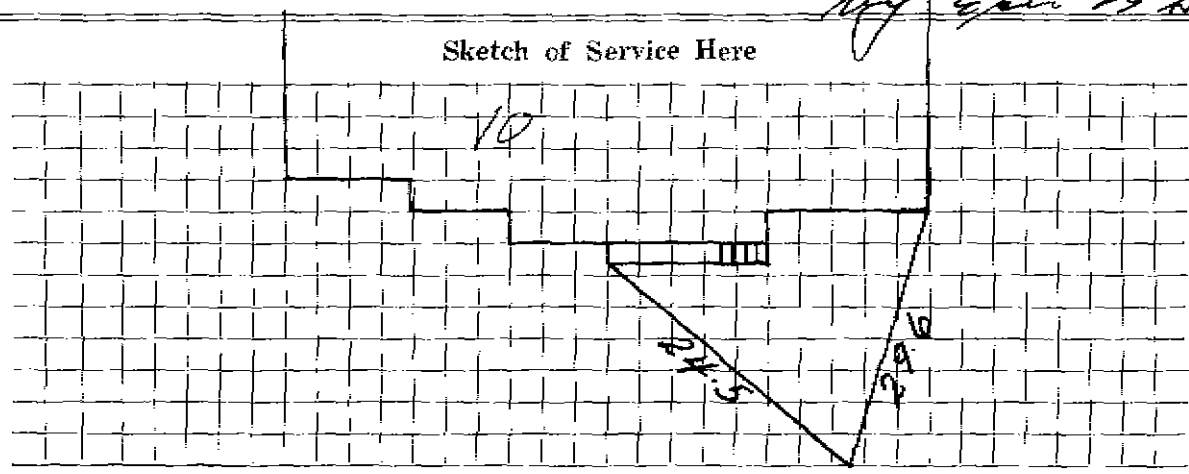

Connection made in \_\_\_\_\_ Street. Work completed \_\_\_\_\_ 19

Remarks: