


DATE _____

TOWN OF LEXINGTON — BOARD OF PUBLIC WORKS
WATER DIVISION

Sketch of Service Here

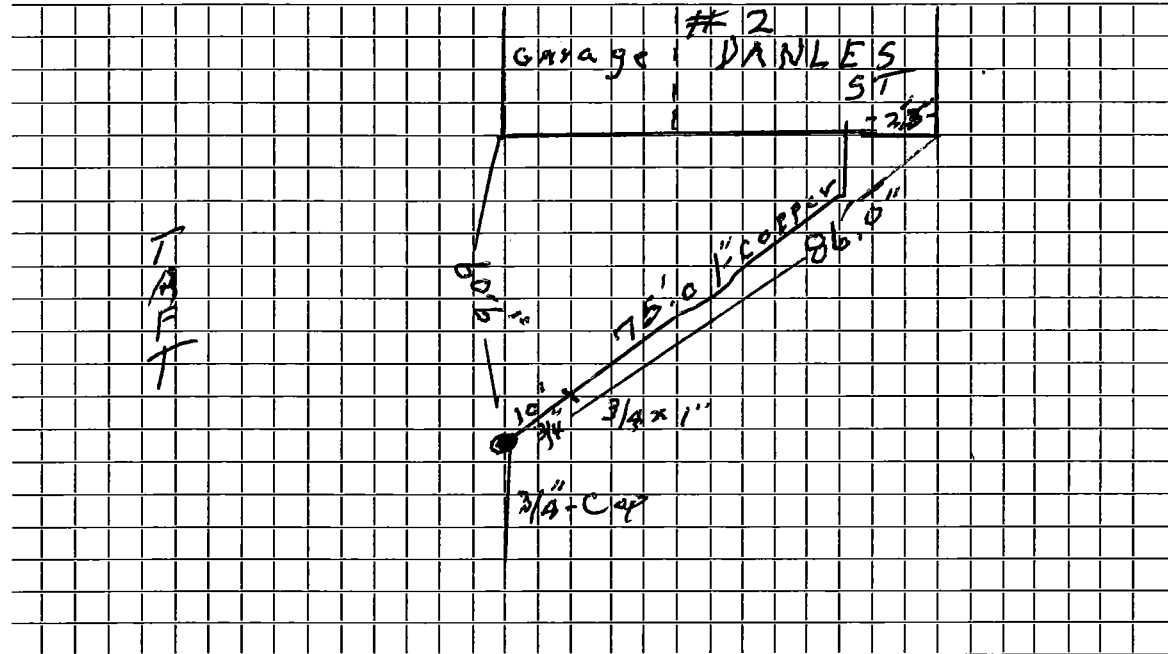

Connection made in..... Street.

Work completed 9/26/2011 J.H.C.I.....

Remarks:.....
.....
.....